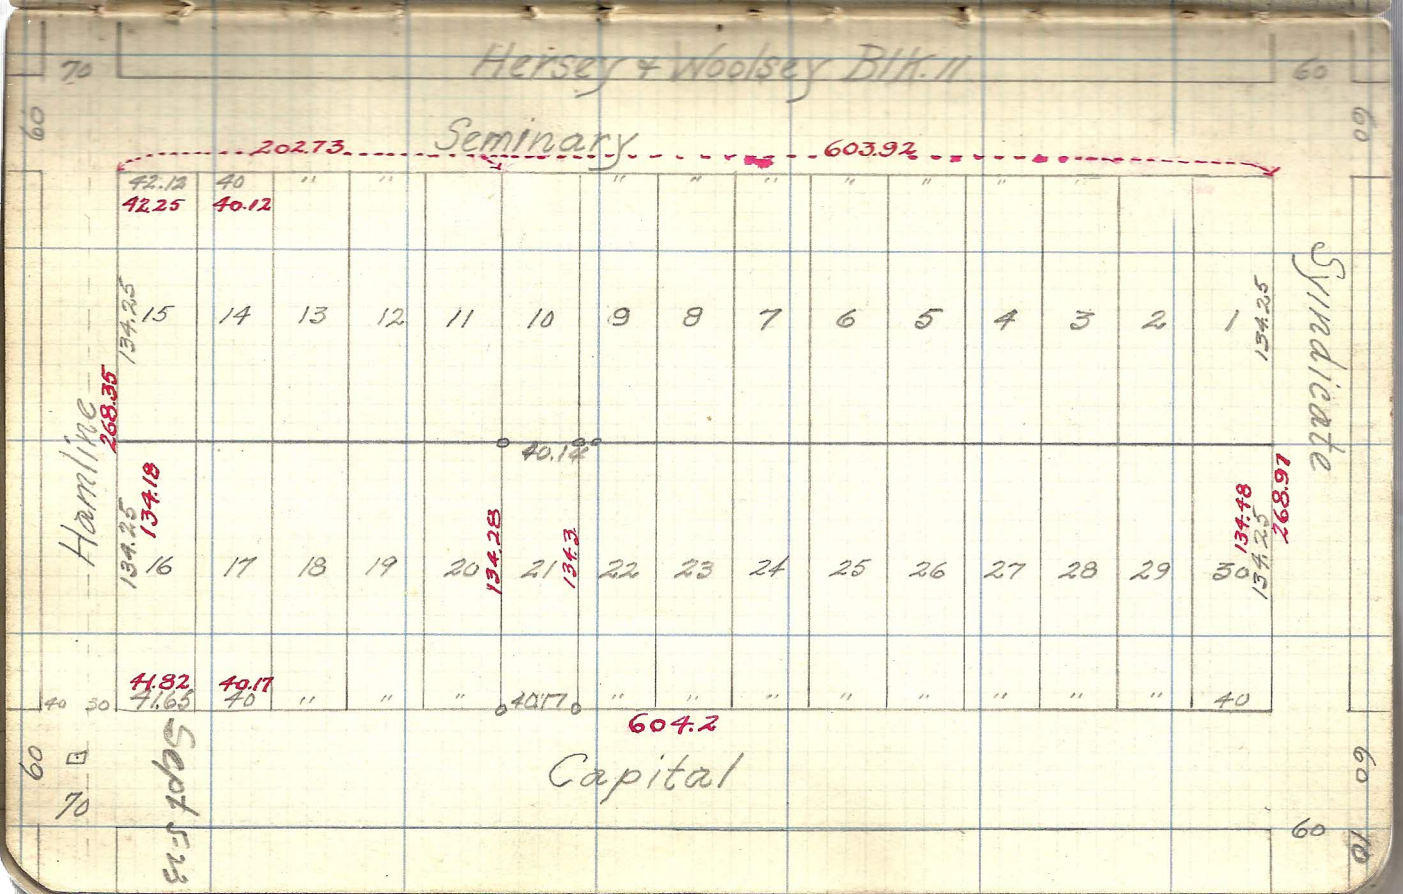
Heisey + Woolsey Blk. 11
Seminary
202.73
603.92
Hamline
Capital
42.12
42.25
40
40.12
15
14
13
12
11
10
9
8
7
6
5
4
3
2
1
134.25
268.35
40.12
134.18
16
17
18
19
20
21
22
23
24
25
26
27
28
29
30
134.28
134.3
134.25
134.78
268.97
41.82
41.65
40
40.17
604.2