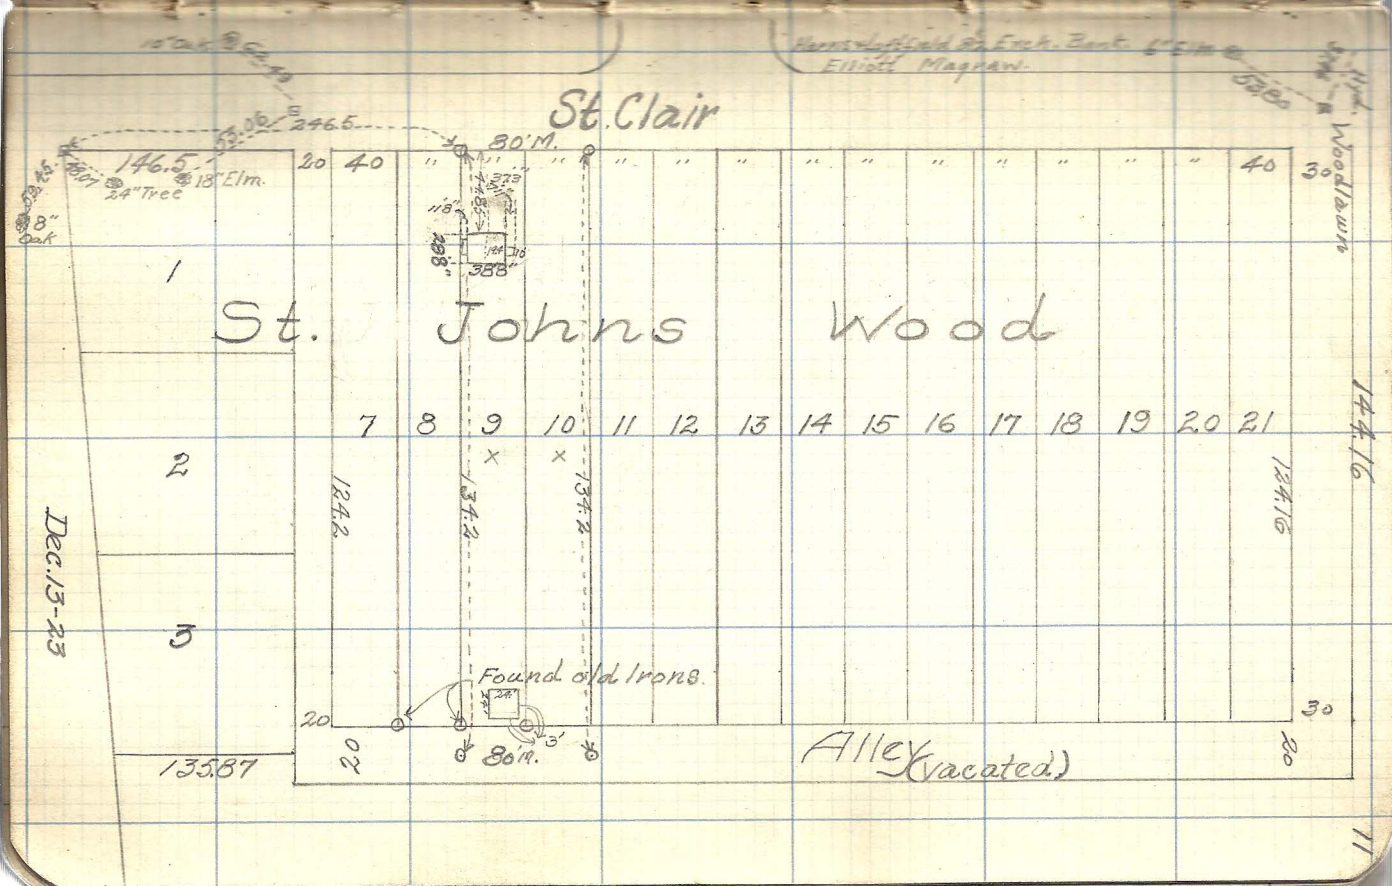

St. Clair
Harris & Hoffield 8½ Exch. Bank
Elliott Magnaw
Woodlawn
146.5
246.5
80' M.
24" Tree
18" Elm.
8" Oak
St. Johns Wood
1
2
3
7
8
9
10
11
12
13
14
15
16
17
18
19
20
21
124.2
134.2
134.2
124.16
144.16
Found old Irons.
80' M.
Alley (vacated)
135.87
Dec. 13-23
11