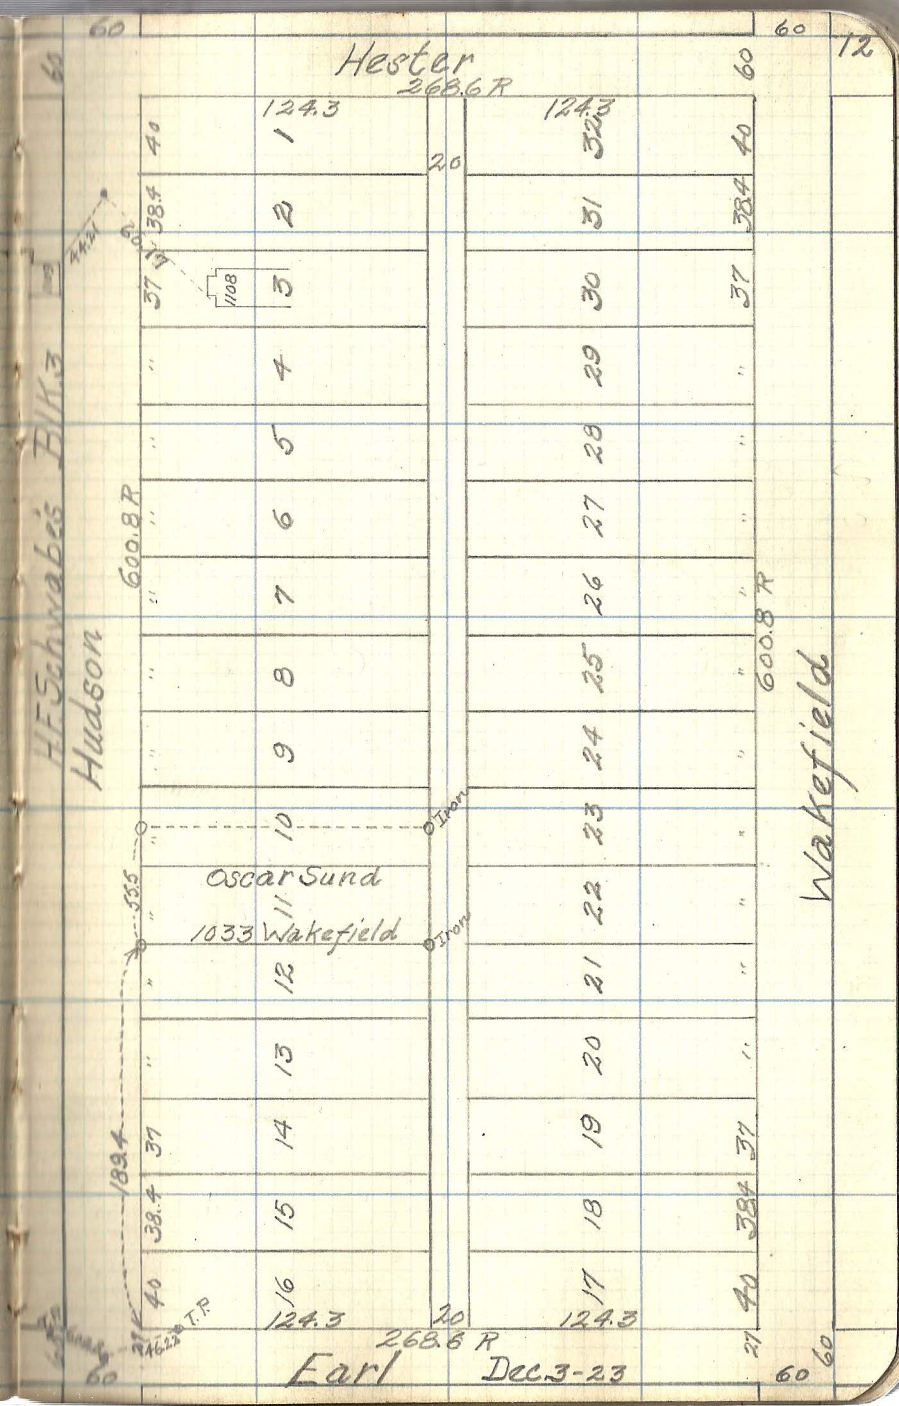

12
Hester
268.6 R
124.3
124.3
20
Hudson
Wakefield
600.8 R
600.8 R
Oscar Sund
1033 Wakefield
Iron
Iron
1108
44.21
55.5
189.4
T.P.
46.22
Earl
Dec 3-23