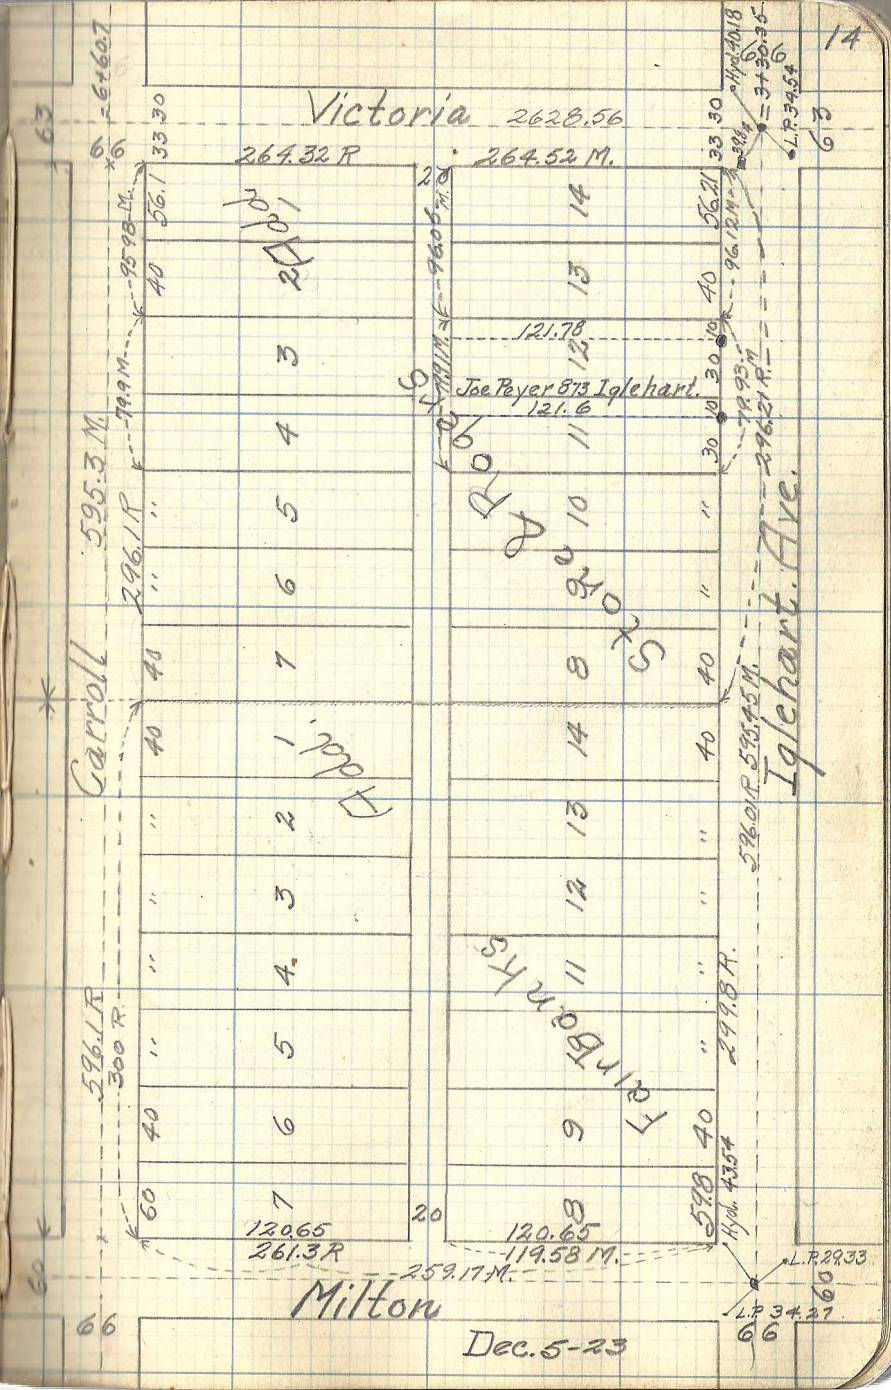
Victoria
2628.56
264.32 R
264.52 M.
Carroll
595.3 M.
596.1 R
300 R.
Iglehart Ave.
Joe Payer 873 Iglehart.
121.78
121.6
120.65
261.3 R
120.65
119.58 M.
259.17 M.
Milton
Dec. 5-23
14