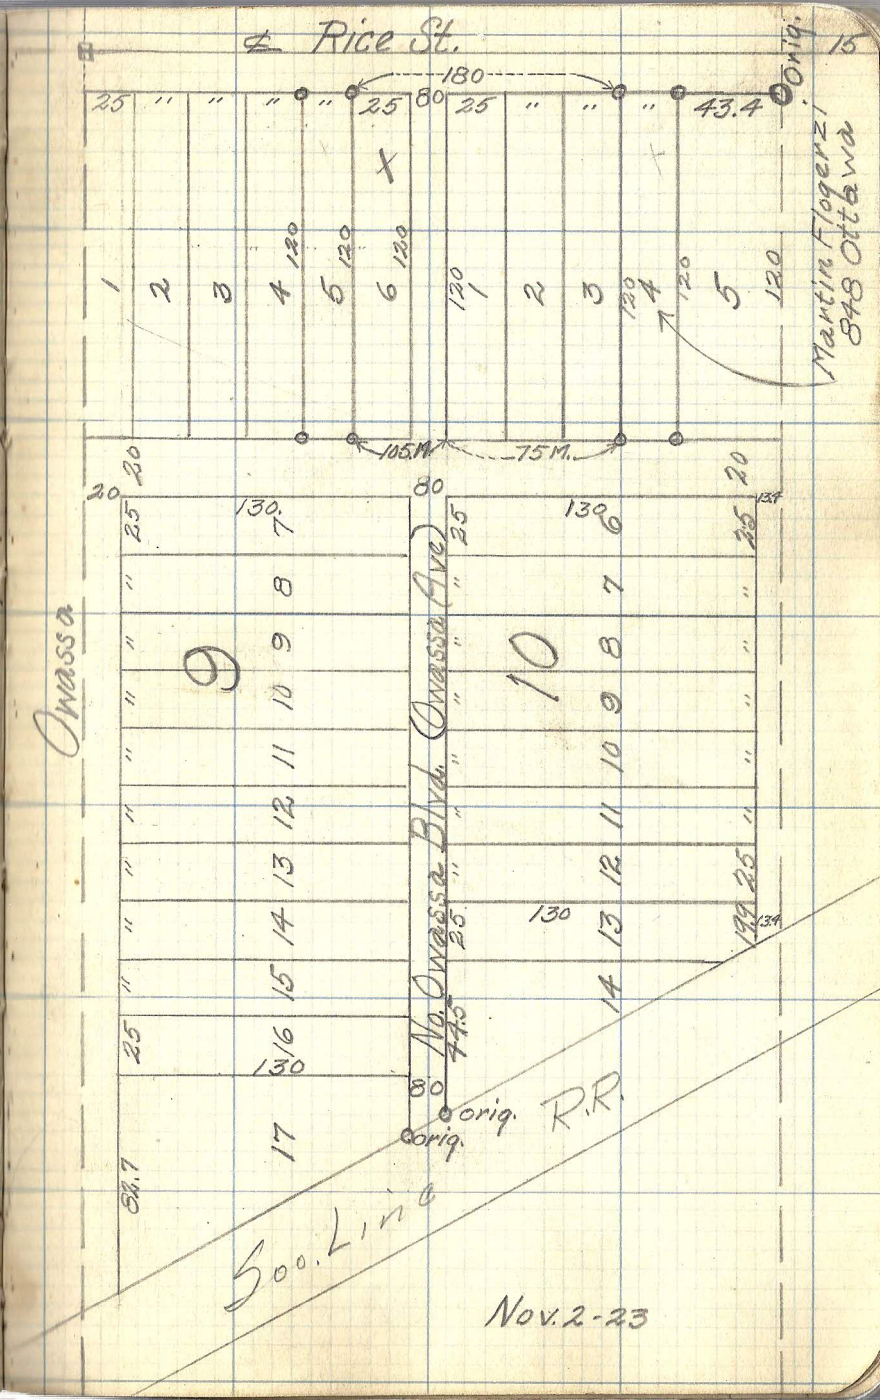Owasso Add Blk 9-10