


Tallula.

68.60° 20' Oak
20° Oak

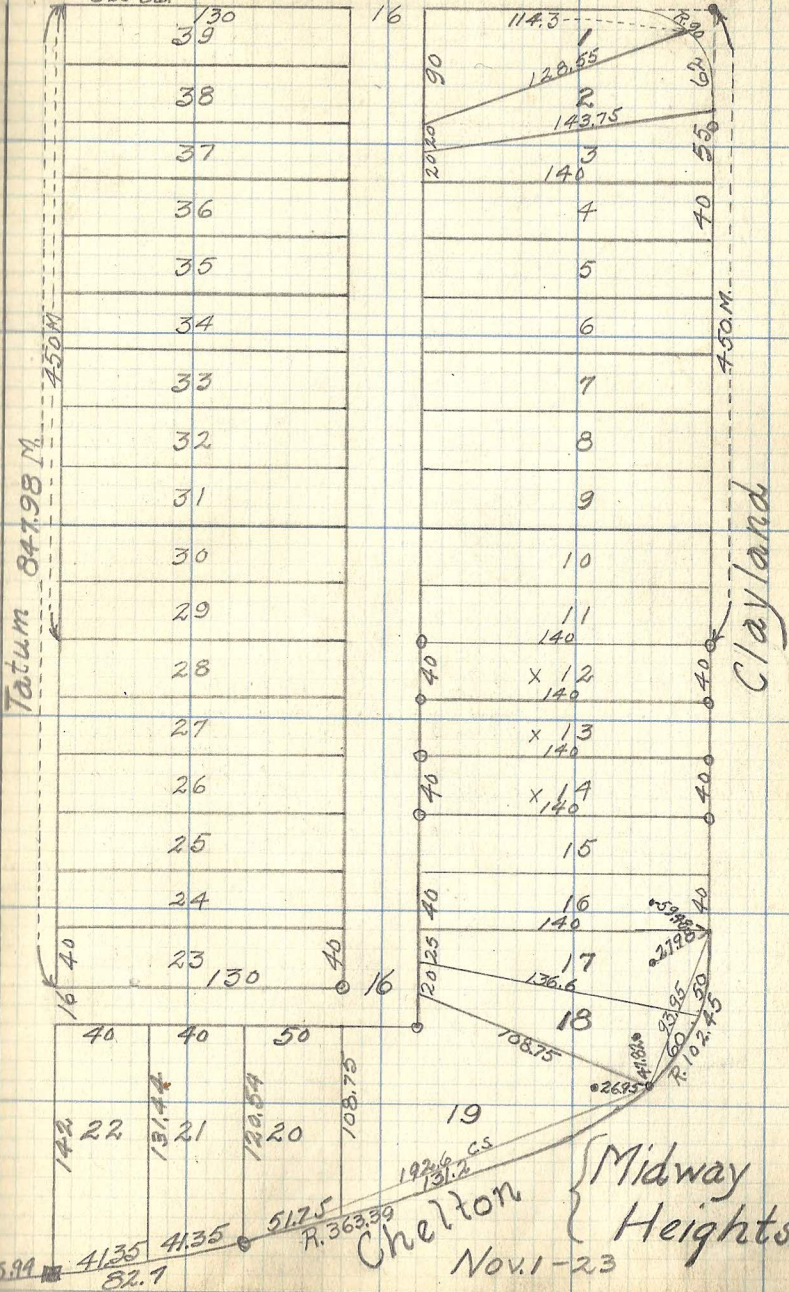

Chelton
Midway Heights
Nov. 1-23