


Albert Ave.

Goodrich Ave.

Fairmount Ave.

Pascal Ave.

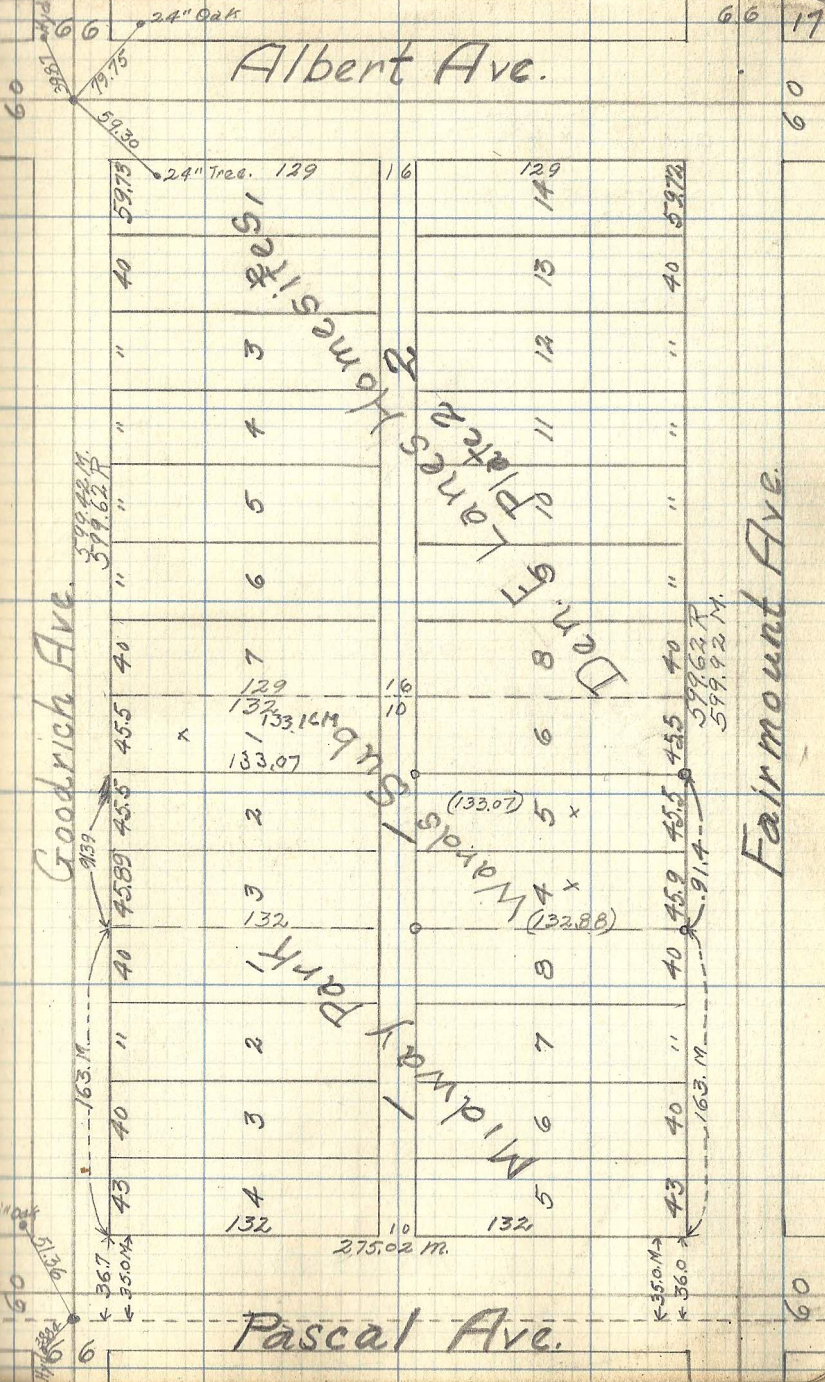

24" Oak
79.75
59.30
388.2
60

24" Tree. 129
59.75

599.92 M.
599.62 F.

599.92 M.
599.62 F.

163.11

51.36
36.7







1
2
3
4
5
6
7
8
9
10
11
12
13
14
15
16

Midway Park
Wards

132
132
133.16 M
133.07

(133.07)
(132.88)

6.6
17
60
60
60