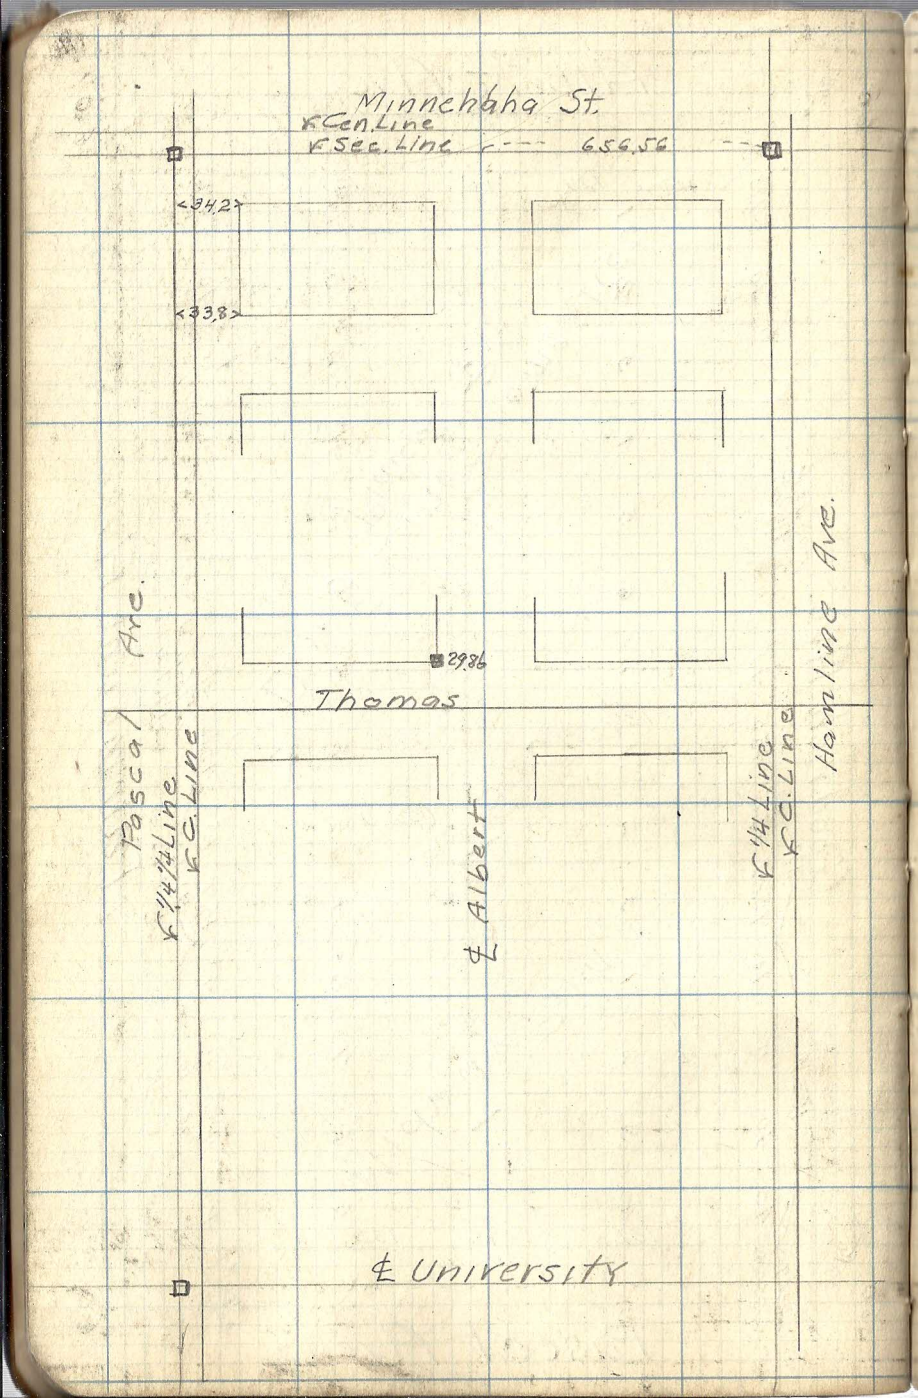
Minnehaha St.
℄ Cen. Line
℄ Sec. Line
656.56
34.2
33.8
29.86
Thomas
Pascal Ave.
℄ 1/4 1/4 Line
℄ C. Line
℄ Albert
℄ 1/4 Line
℄ C. Line
Hamline Ave.
℄ University

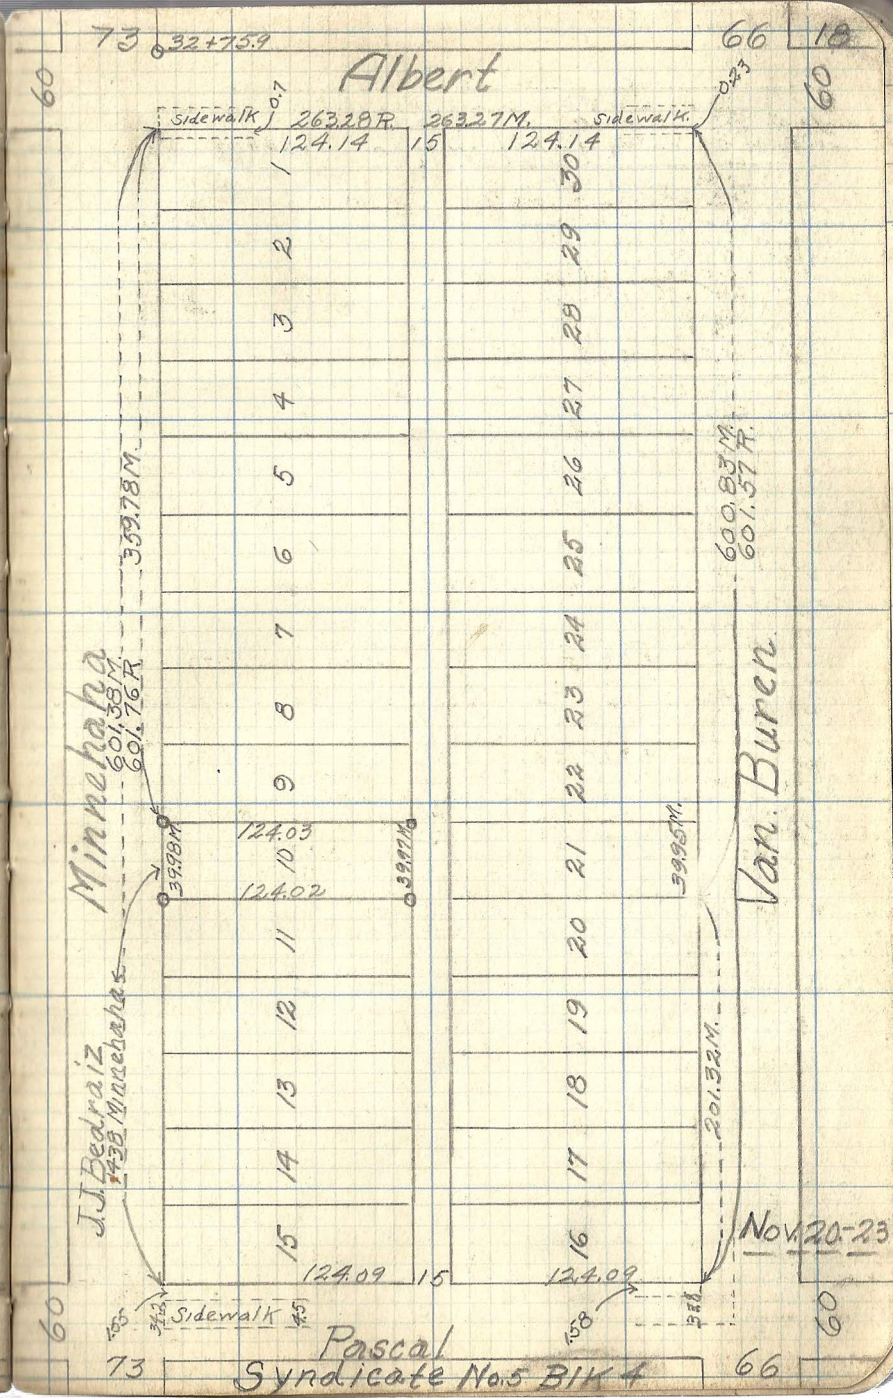
73
32+75.9
66
18
Albert
60
Sidewalk
0.7
263.28 R.
263.27 M.
Sidewalk
0.23
124.14
15
124.14
1
2
3
4
5
6
7
8
9
10
11
12
13
14
15
30
29
28
27
26
25
24
23
22
21
20
19
18
17
16
359.78 M.
601.38 M.
601.76 R.
600.83 M.
601.57 R.
Minnehaha
Van Buren
124.03
124.02
39.98 M.
39.97 M.
39.95 M.
J.J. Bedraiz
438 Minnehahas
201.32 M.
Nov. 20-23
124.09
15
124.09
Sidewalk
1.55
34.2
4.5
1.58
38.8
Pascal
Syndicate No. 5 Blk 4
73
66