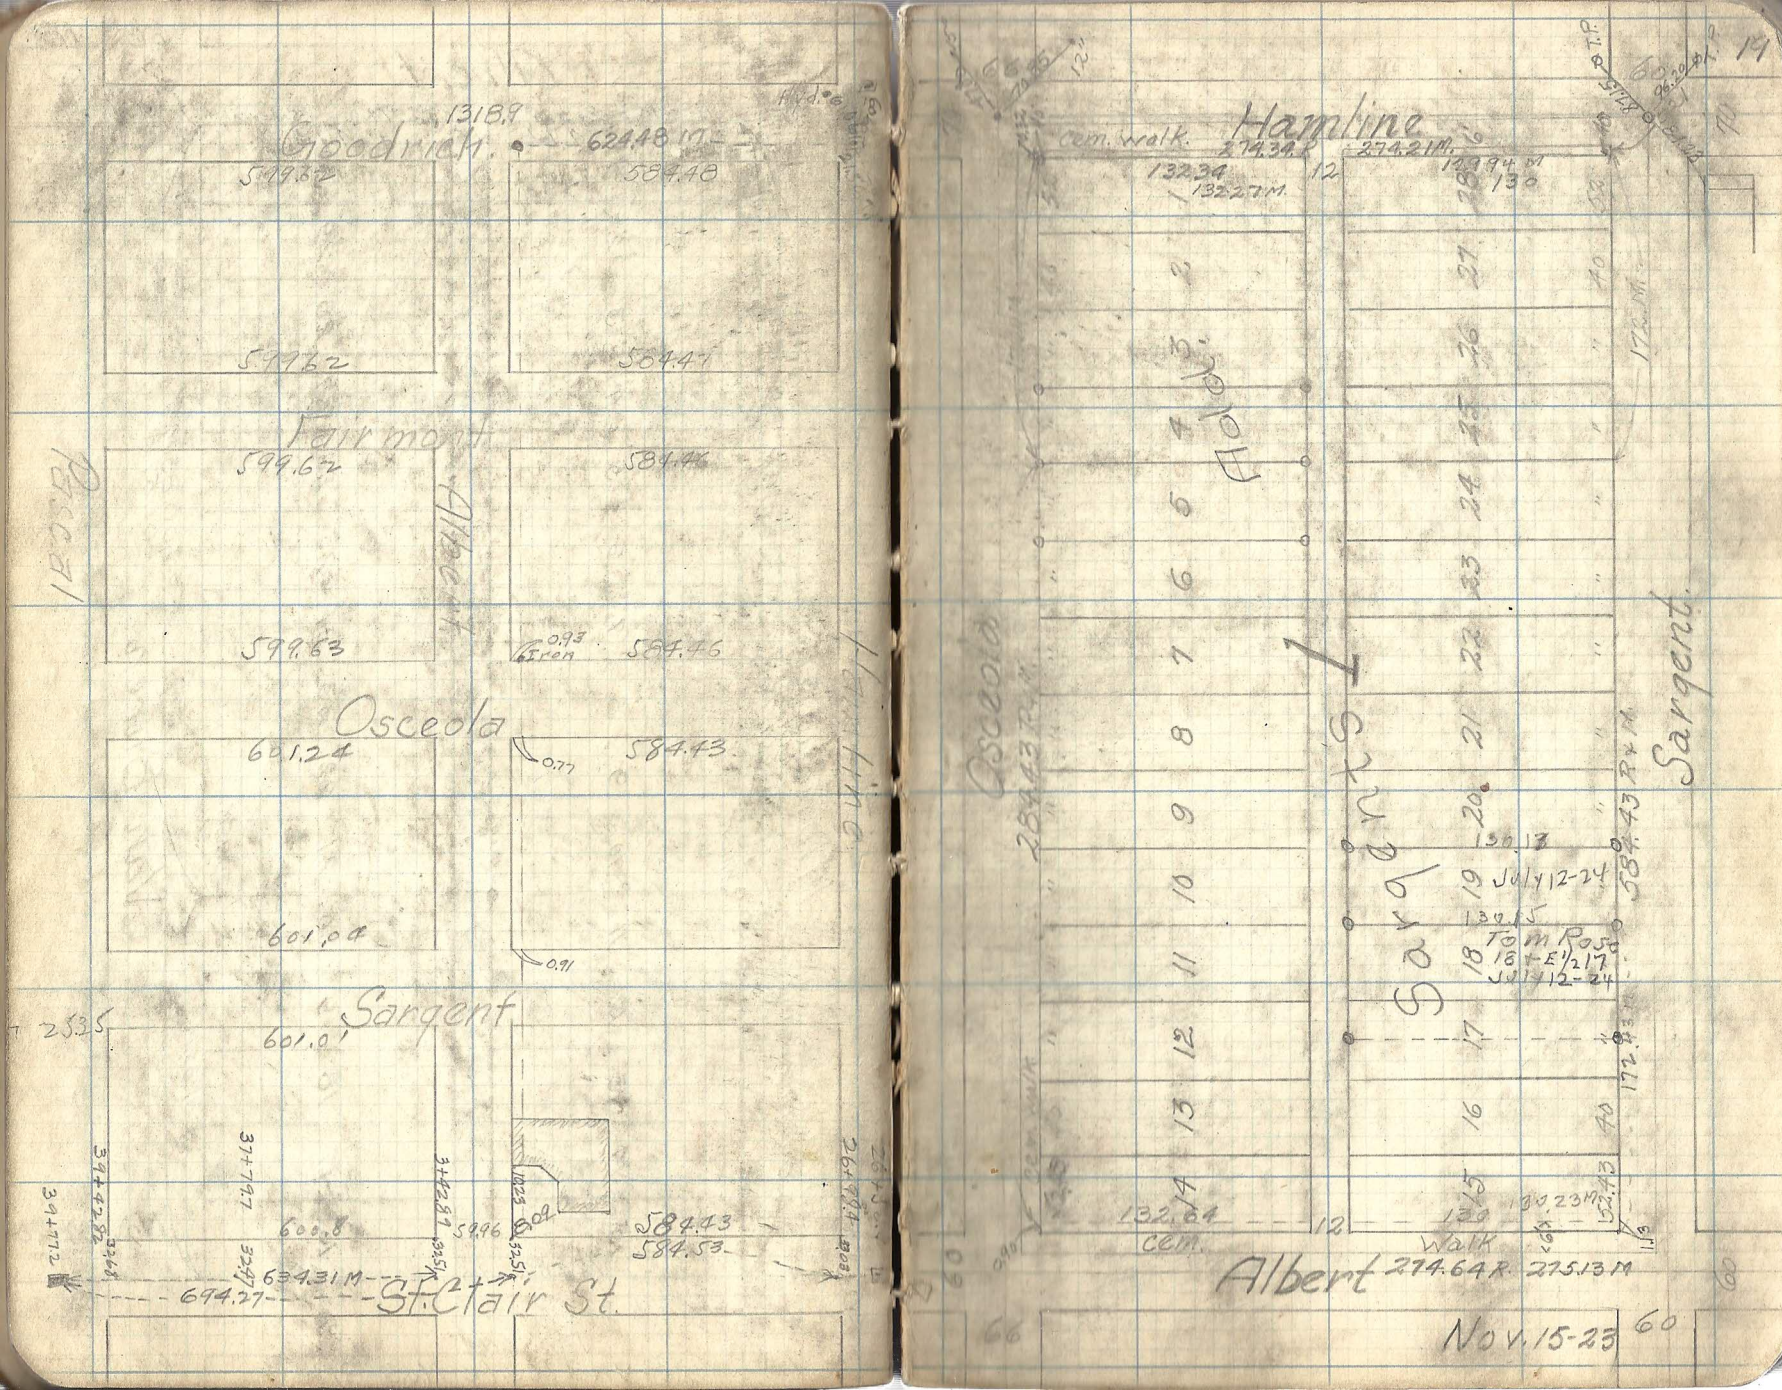
Goodrich
1318.9
624.48 M
599.62
584.48
599.62
584.47
Fairmont
599.62
584.46
599.63
0.93
Gren
584.46
Osceola
601.24
584.43
0.77
601.04
0.91
Sargent
601.01
584.43
584.53
St. Clair St.
694.27
Hamline
cem. walk
274.34
274.21 M.
132.34
132.27 M.
12
12994 SF
130
Osceola
284.43 R+M
Sargent
284.43 R+M
130.13
July 12-24
130.15
Tom Rose
16 - E 1/2 17
JJ 1-12-24
172.4 M
Albert
274.64 R. 275.13 M
cem. walk
132.64
130
Nov. 15-23
60
66