


Manson & Simontons B/K. 3

Grand Ave.

Lincoln Ave.

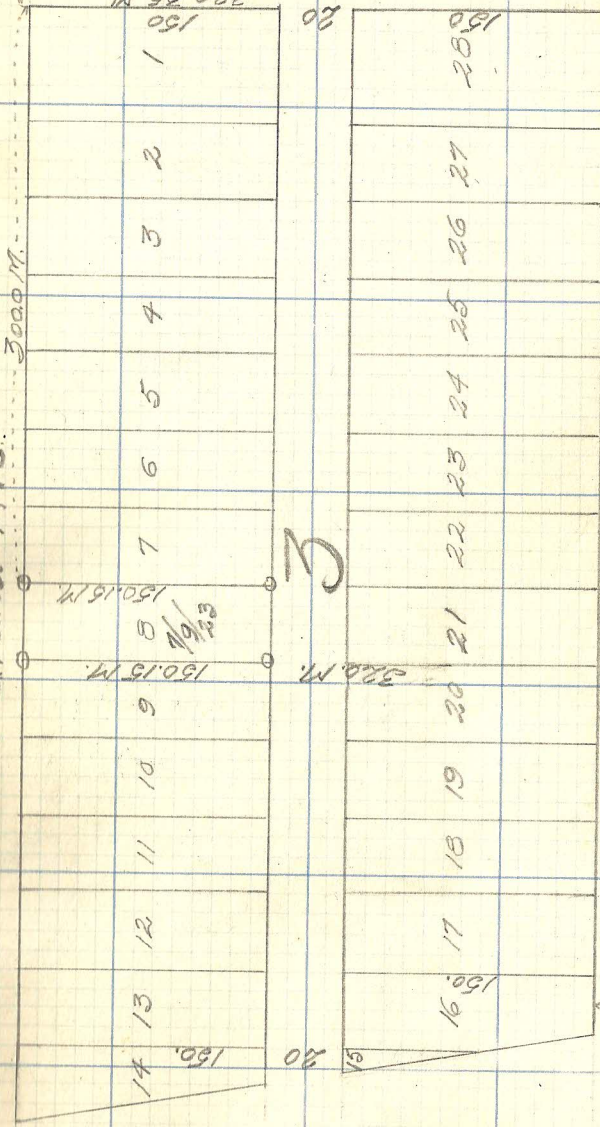

Dunlap

80

60

320.35 M.

20

66

3000 M.

300 M.

150.15 M.

150.15 M.

320 M.

150.

20

150.

66

St. P. Ry. C.M. & July 9-23

80

4