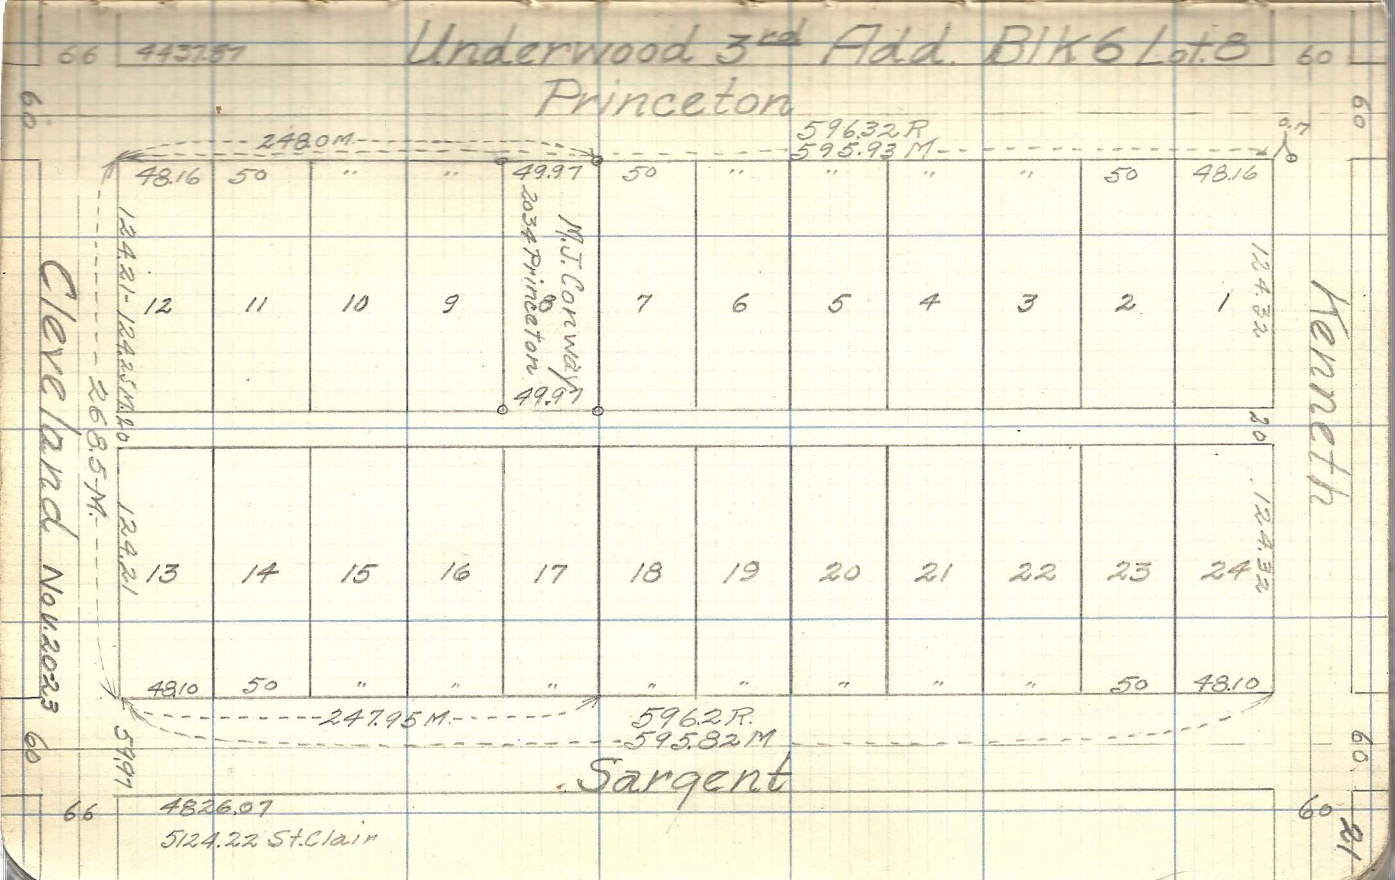
Underwood 3rd Add. Blk 6 Lot 8
Princeton
Kenneth
Cleveland
Sargent
248.0M
596.32R
595.93M
247.95M
596.2R
595.82M
268.5M
123.21-124.21
123.32-124.32
48.16
50
49.97
2034 Princeton
49.97
48.10
12
11
10
9
8
7
6
5
4
3
2
1
13
14
15
16
17
18
19
20
21
22
23
24
4826.07
5124.22 St. Clair