

Dewey

Merriam Pk. 2nd Add. B.K. II


Dayton 500.3 M.

66

66

319.58 M.

320.12 M.

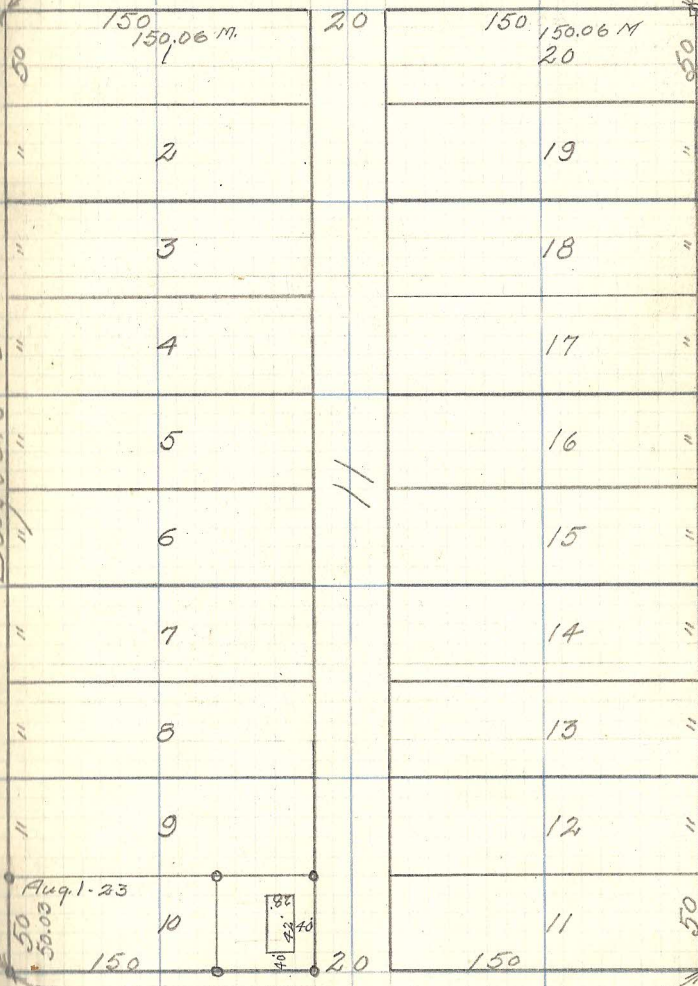

Howell

Aug. 1-23

319.52 M.

66

66