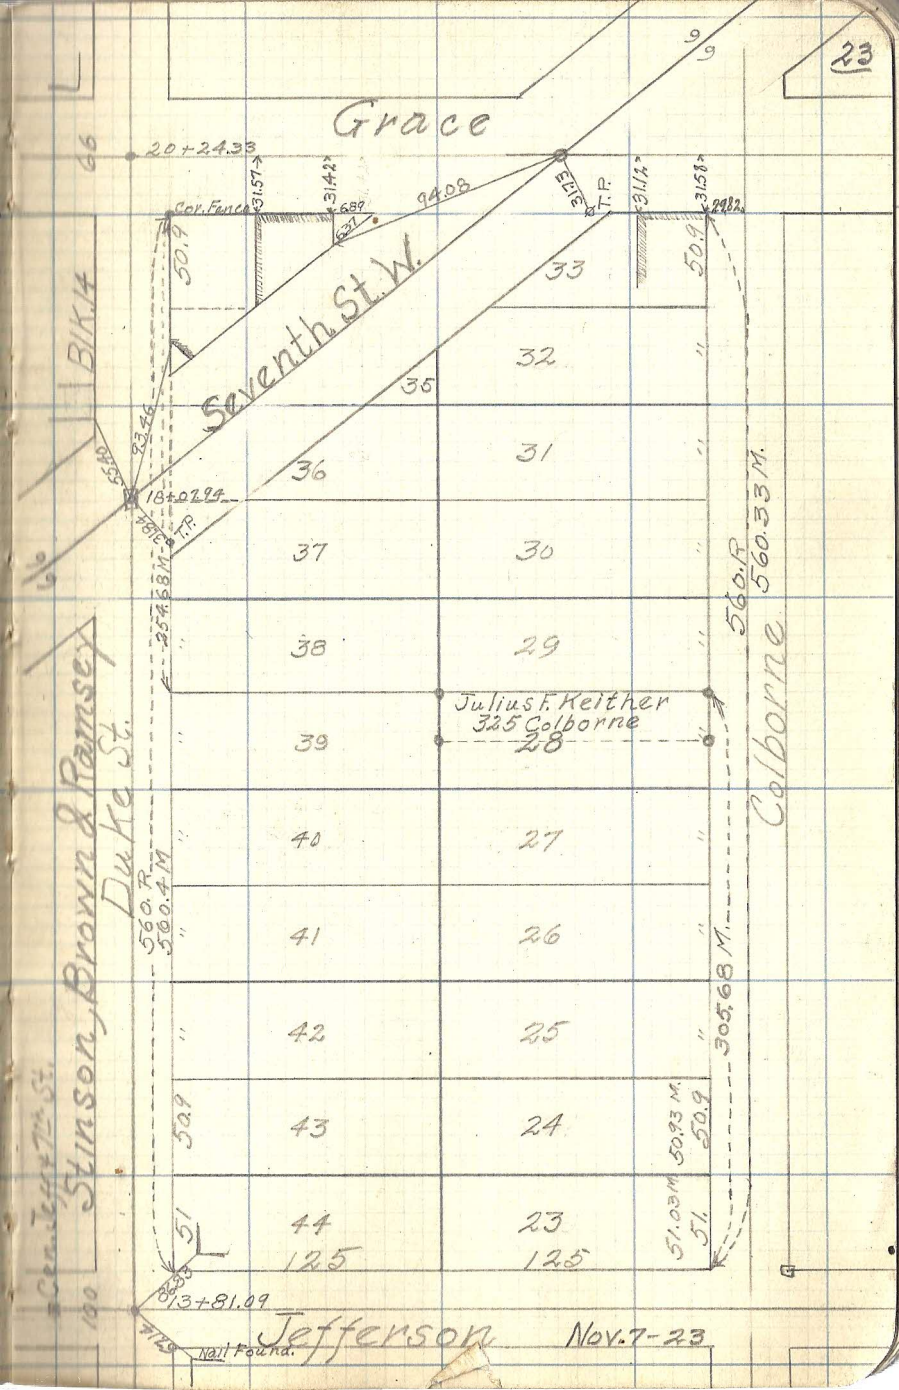
Grace
20+24.33
31.57
31.42
Cor. Fence
.689
.637
94.08
T.P.
31.42
31.57
29.82
50.9
Seventh St. W.
33
32
35
36
31
18+02.24
T.P.
37
30
38
29
Julius F. Keither
325 Colborne
28
39
40
27
41
26
42
25
43
24
44
23
125
125
50.9
50.93 M.
51.03 M.
51
560 R
560.33 M.
Colborne
560 R
560.4 M.
Stinson, Brown & Ramsey
Duke St.
305.68 M.
254.68 M.
23.46
5.60
13+81.09
Jefferson
Nail Found.
NOV. 7-23
L
66
120
10
9
9