


Elmwood Add. Blk 2  
 Jefferson

Macalester 271. Rec.  
 270.89 M

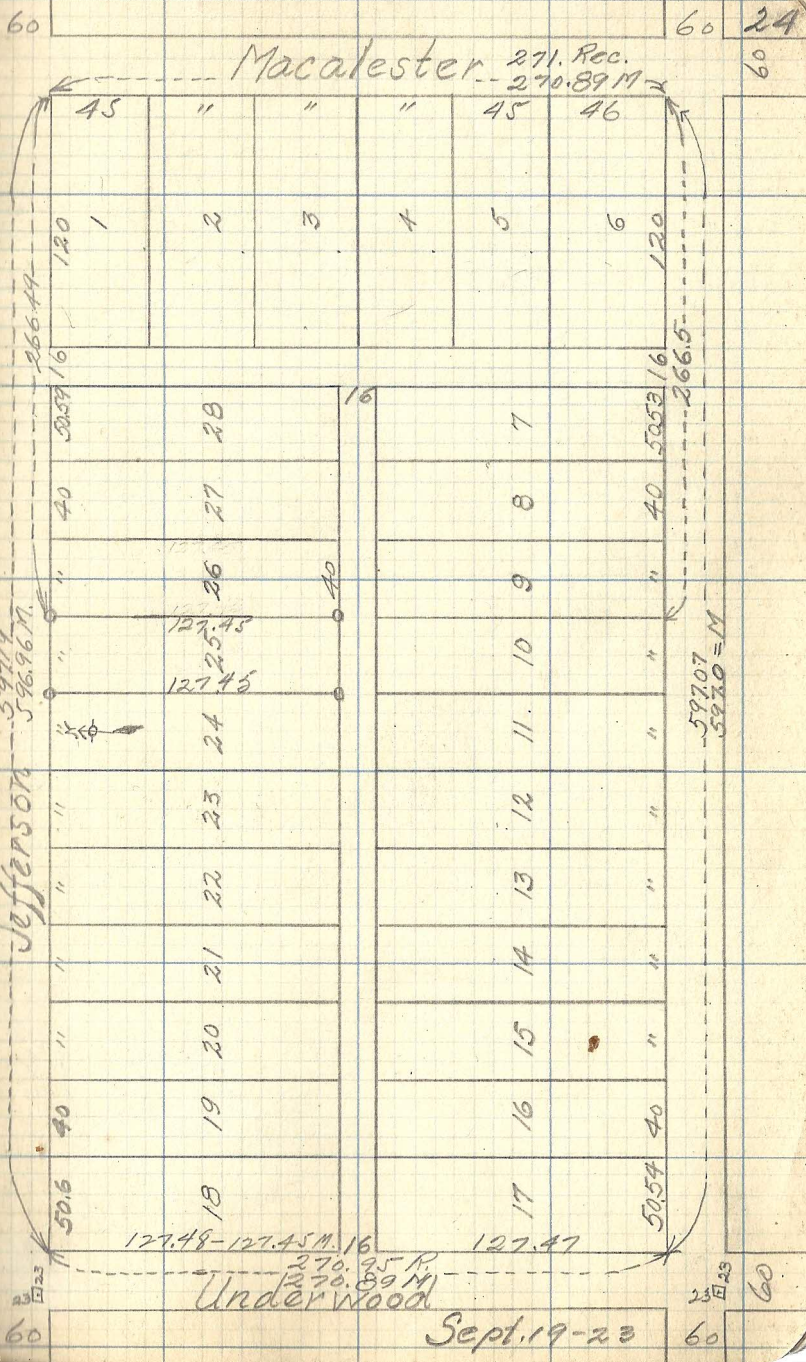

Sept. 19-23