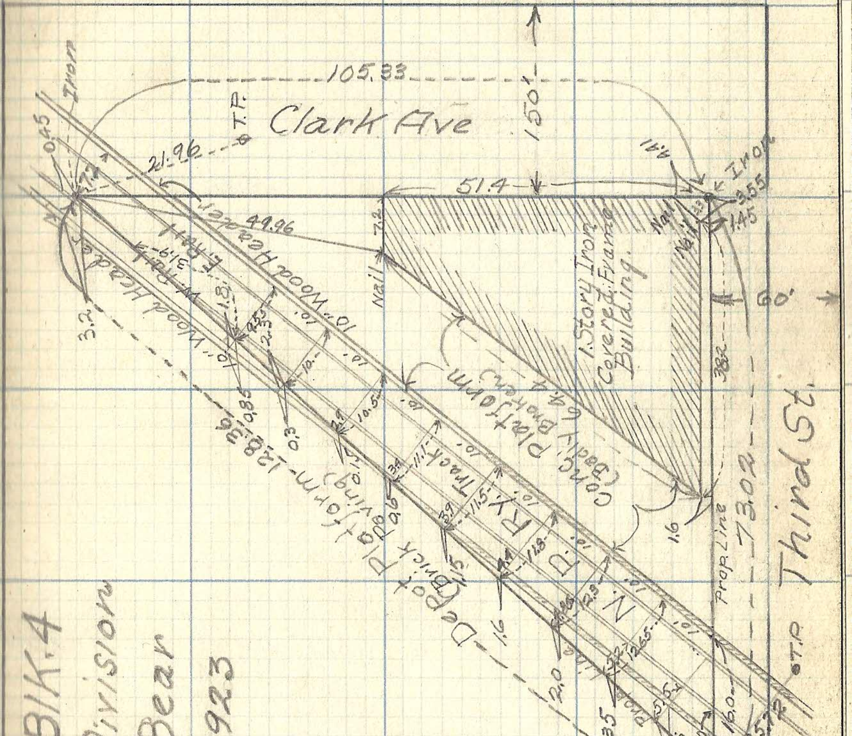
Lot 6 Blk 4
Central Division
White Bear
Sept. 14 1923
Clark Ave
Third St.
105.33
150
51.4
60.
73.02
128.36
49.96
21.96
1 Story Iron Covered Frame Building
Conc. Platform (Badly Broken)
Depot Platform (Brick Paving)
N. P. Ry
Track
Wood Header
E. Rail
W. Rail
Iron
Nail
T.P.
Prop Line

Sept. 14-23