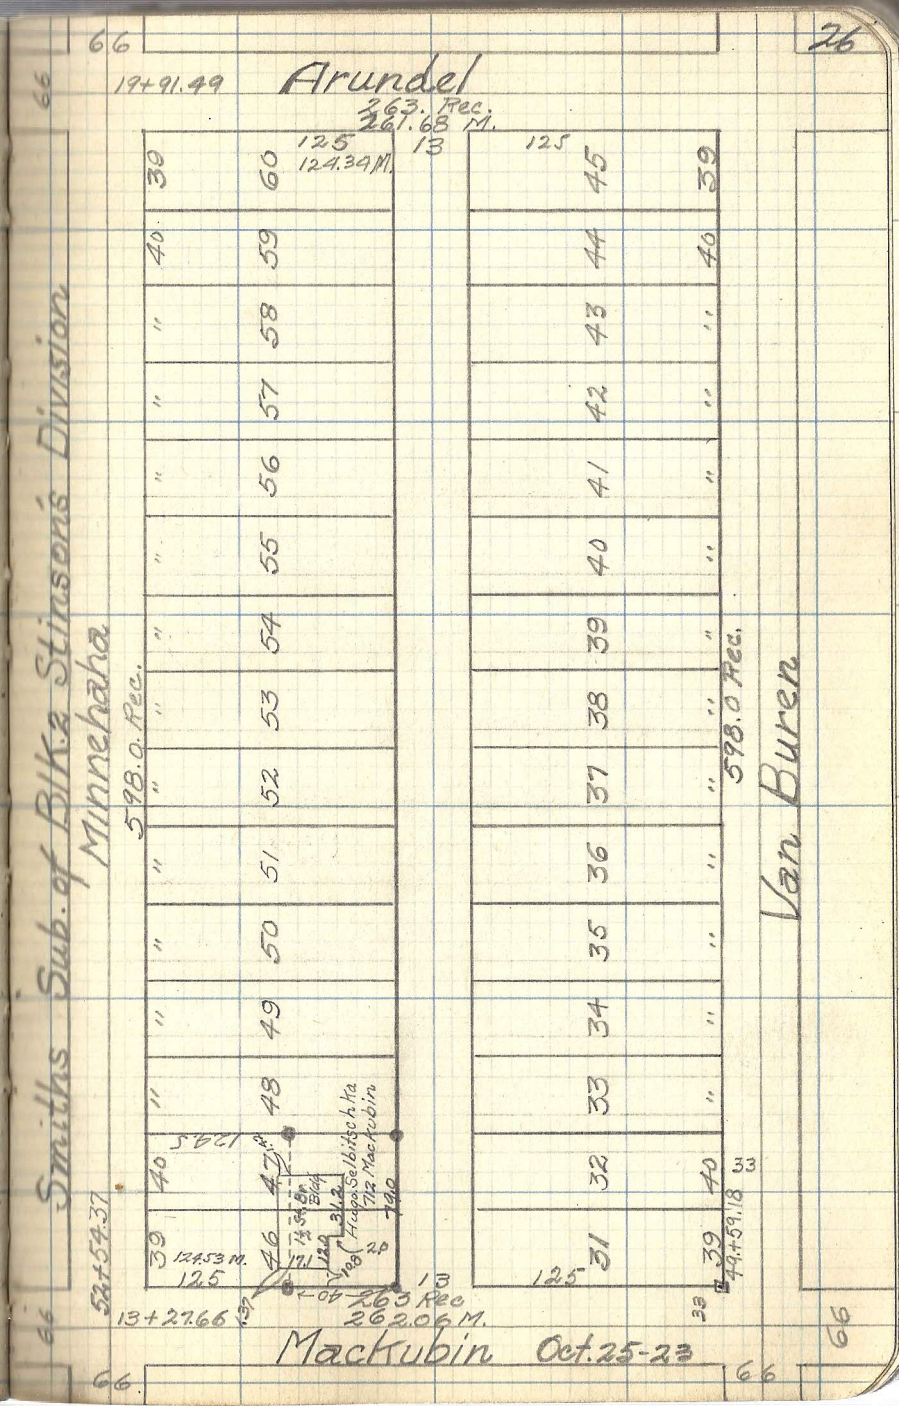
66
19+91.49
Arundel
263. Rec.
261.68 M.
125
124.34 M.
13
125
39
60
45
39
40
59
44
40
"
58
43
"
"
57
42
"
"
56
41
"
"
55
40
"
"
54
39
"
"
53
38
"
"
52
37
"
"
51
36
"
"
50
35
"
"
49
34
"
"
48
33
"
40
47
32
40
39
46
31
39
124.5
Hugo Selbitschka
712 Mackubin
79.0
31.2
124.53 M.
125
13
125
263 Rec
262.06 M.
13+27.66
52+54.37
49+59.18
33
33
Smiths Sub. of Blk. 2 Stinson's Division
Minnehaha
598.0 Rec.
598.0 Rec.
Van Buren
Mackubin Oct. 25-23
66
66
66
66