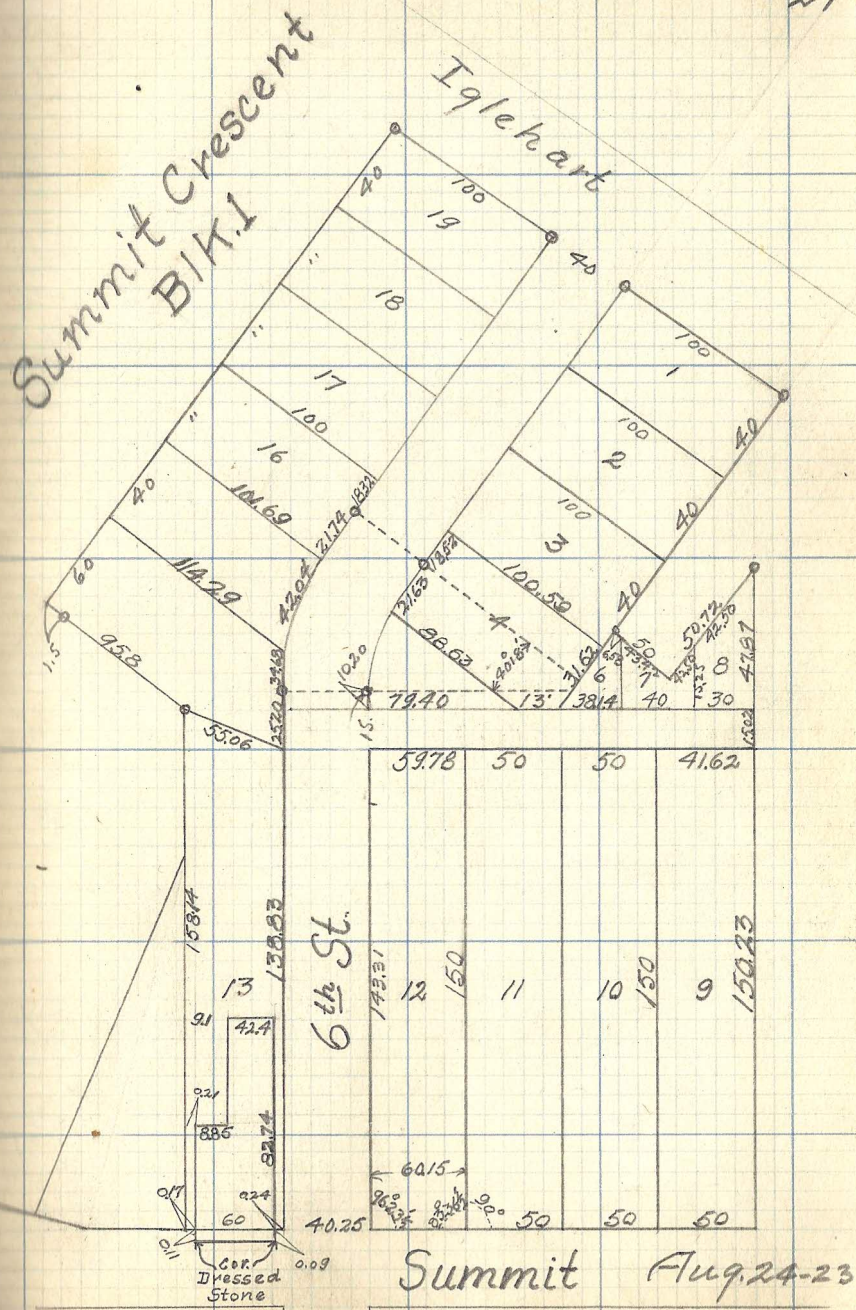
Summit Crescent
Blk.1
Iglehart
6th St.
Summit
Aug. 24-23
Cor. Dressed Stone
19
18
17
16
1
2
3
4
6
7
8
9
10
11
12
13
40
100
101.69
114.29
95.8
55.06
21.74
42.04
18.32
18.52
21.63
100.59
88.63
40.18
31.62
79.40
13
38.14
40
30
50.72
42.50
47.87
15.02
59.78
50
41.62
143.31
150
150.23
60.15
158.14
138.83
9.1
42.4
0.21
8.85
82.74
0.17
0.24
60
40.25
0.11
0.09