


Dale St

240.85 M

Dayton Ave.  
598.14

299.07

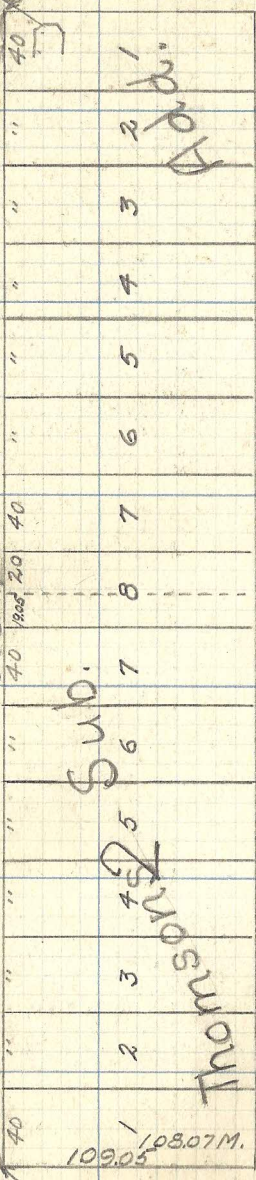

Sub.

Thompson

Combs

Moss  
1020  
lots

Selby Ave.

4+08.7

3.15M 4+22.5

109.05 108.07 M.

20

138.75 M.

St. Albans

Oct. 29-23

110.05 M 89.0

110. M. 11. R. 89.0

E. 30° 110° M.

E. 30° 3.22

10 150

10 150

10 150

10 150

10 150

10 150

10 150

10 150

10 150

10 150

299.23

40

E. 30°

598.14 M. 916

299.23

299.23

222

30°

71.25 M

30

40

40

40

40

40

40

40

40

40

40

40

40

40

40

40

4+08.39

4+22.11 752.6 627.9

40

40

40

40

40

40

40

40

40

40

40

40

40

40

40

40