White Bear Lake

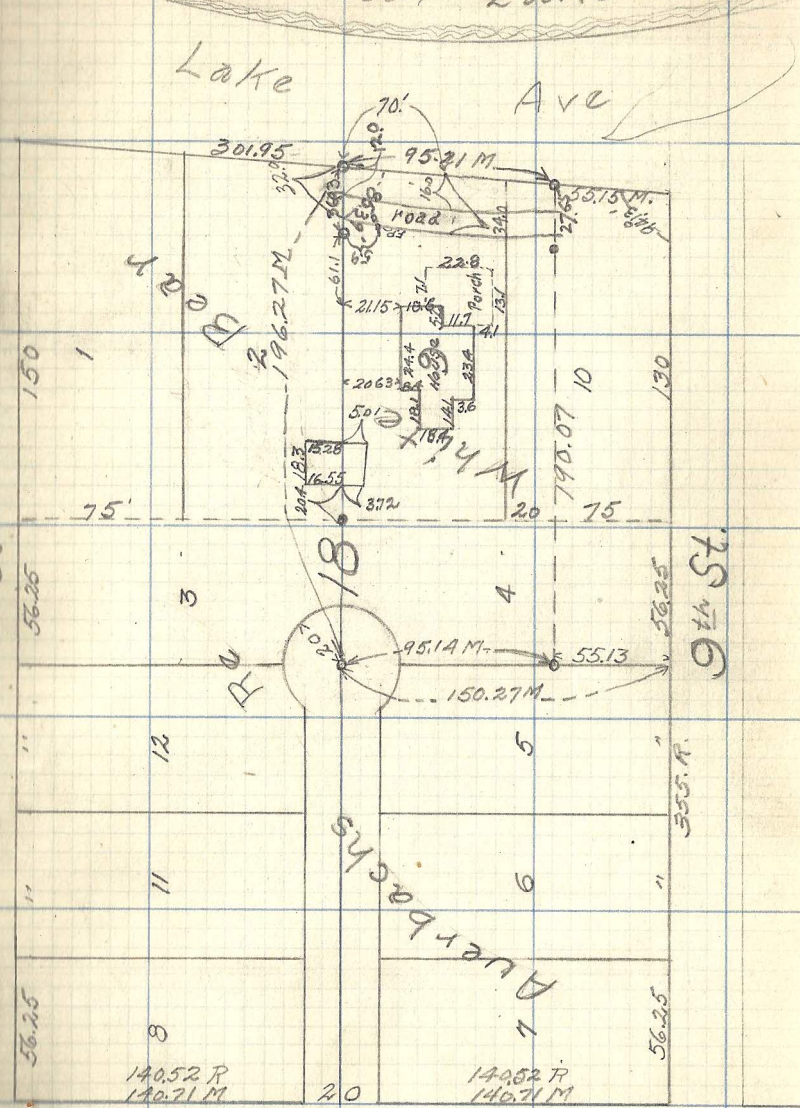

Oct 15-23

Johnson