Sec. 2 T. 29 R. 23.

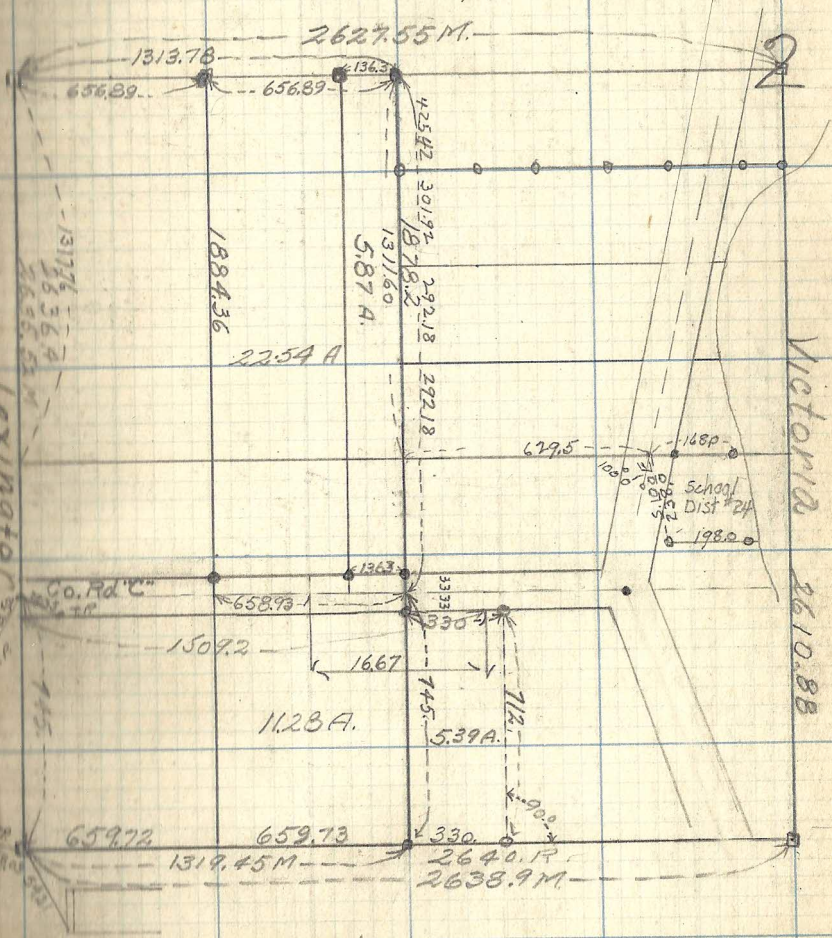
2627.55 M.
1313.78
656.89
656.89
136.3
425.42
301.92
1878.2
1311.60
5.87 A.
1884.36
22.54 A
292.18
292.18
629.5
168.0
School Dist #24
198.0
Victoria
2610.88
Lexington
136.3
Co. Rd "C"
658.93
330
1509.2
16.67
745
712
11.28 A.
5.39 A.
90.0
659.72
659.73
330.
1319.45 M
2640. R
2638.9 M