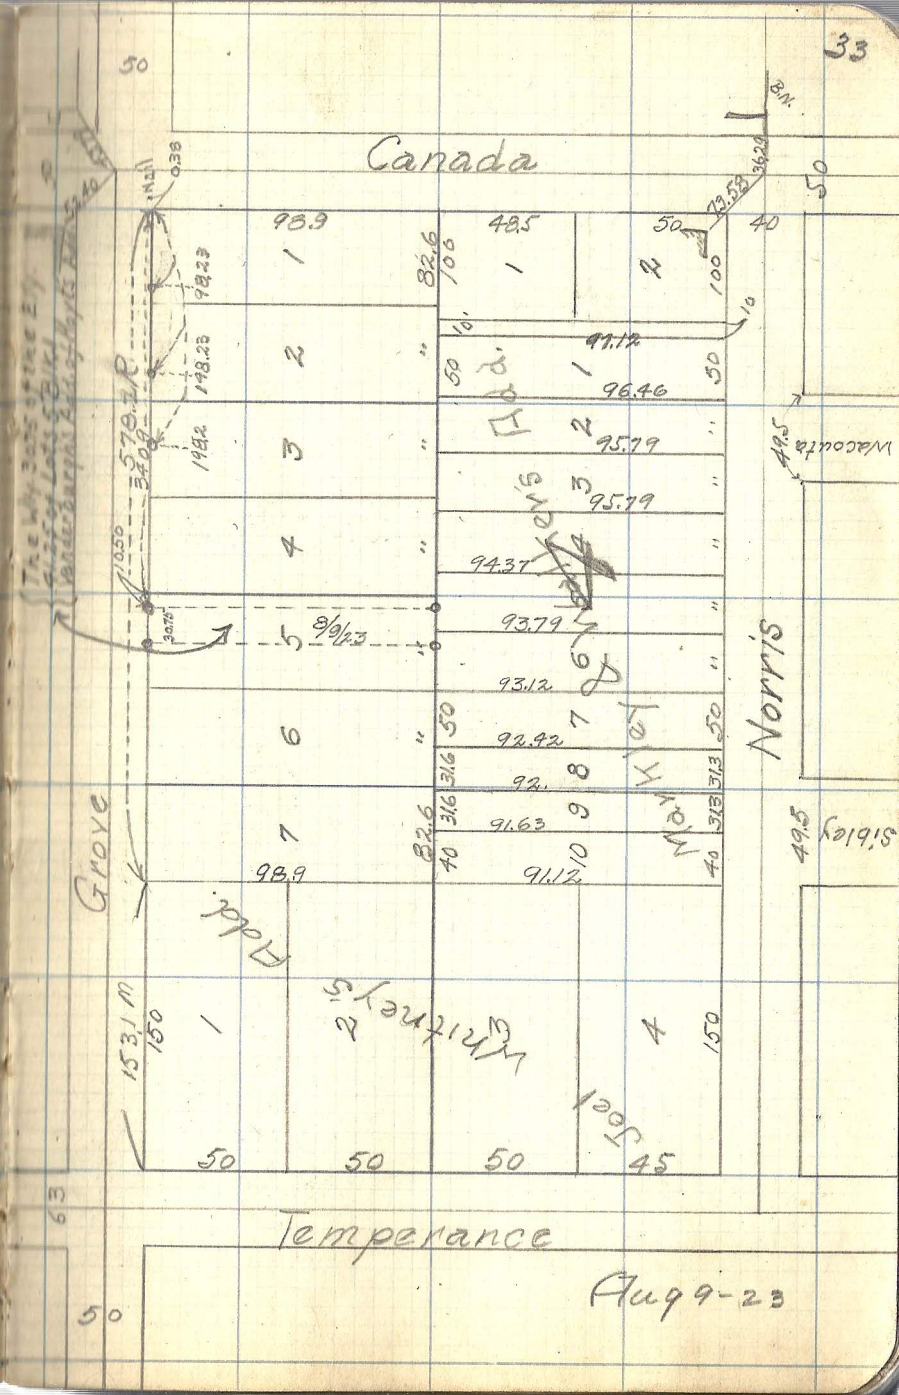
Canada
Norris
Grove
Temperance
Sibley
Macouta
Whitney's Add.
Joel
Markley & Walters Add.
98.9
48.5
82.6
100
50
40
73.58
36.29
B.N.
98.23
198.23
198.2
578.2 R
34.09
10.50
30.75
8/9/23
91.12
96.46
95.79
94.37
93.79
93.12
92.42
92.
91.63
91.12
31.6
31.3
49.5
153.1 M
150
45
63

Aug 9-23