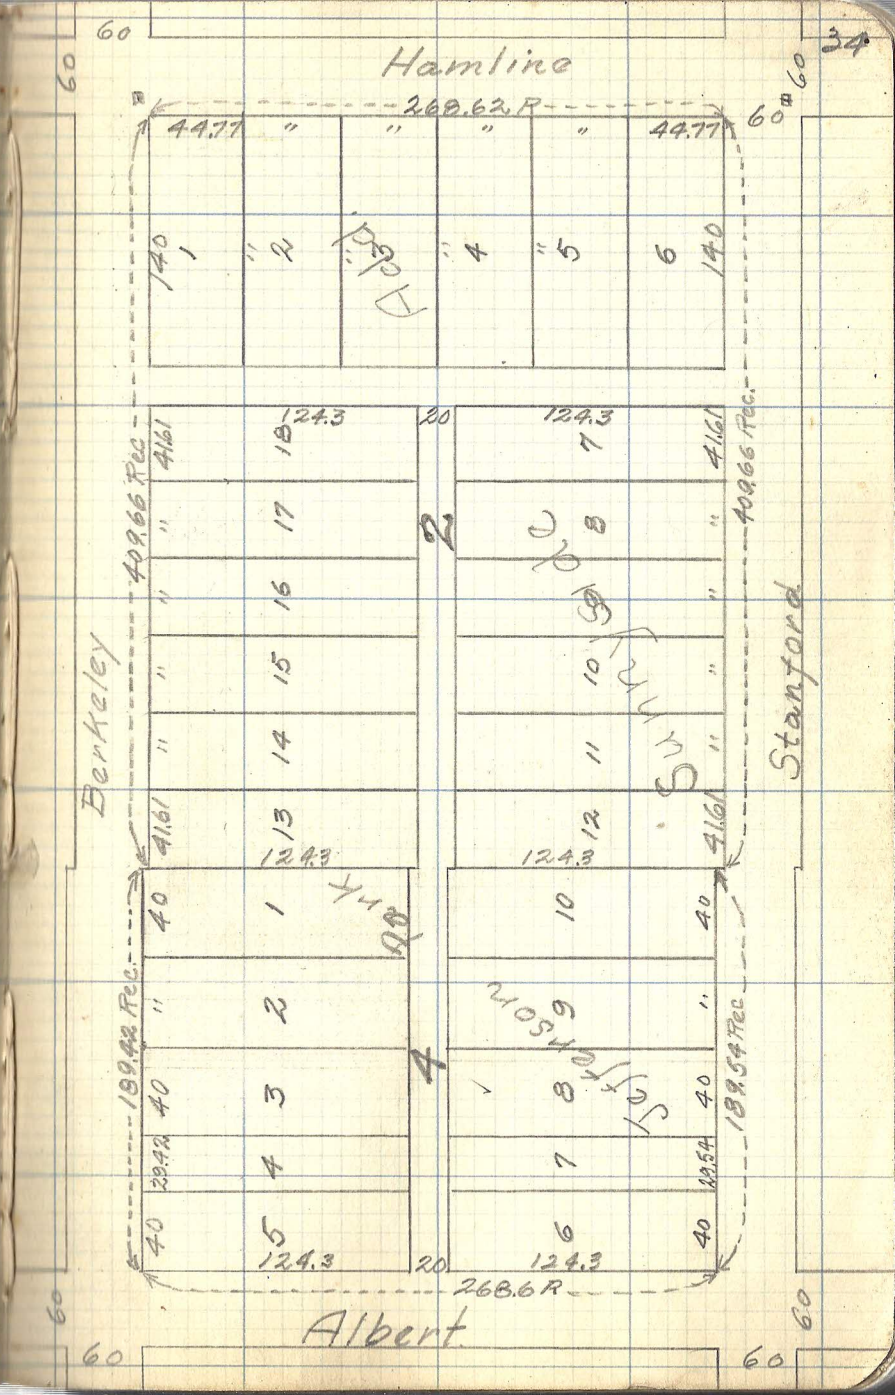Refer to Book 3 Page 26