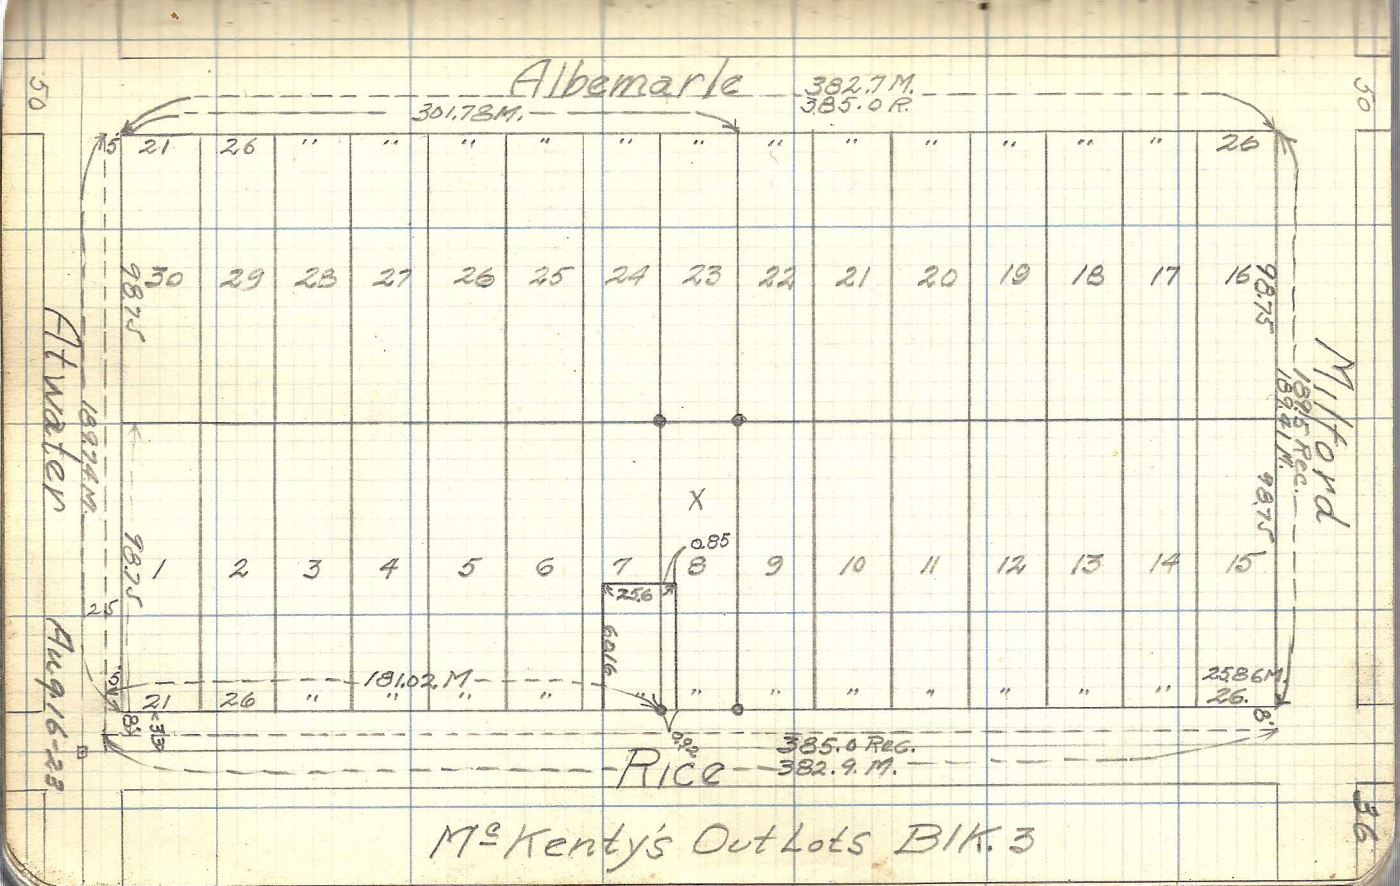
Albemarle
382.7 M.
385.0 R.
301.78 M.
Milford
Atwater
Aug. 16-23
Rice
385.0 Reg.
382.9 M.
181.02 M.
25.86 M.
26.
Mc Kenty's Outlots Blk. 3