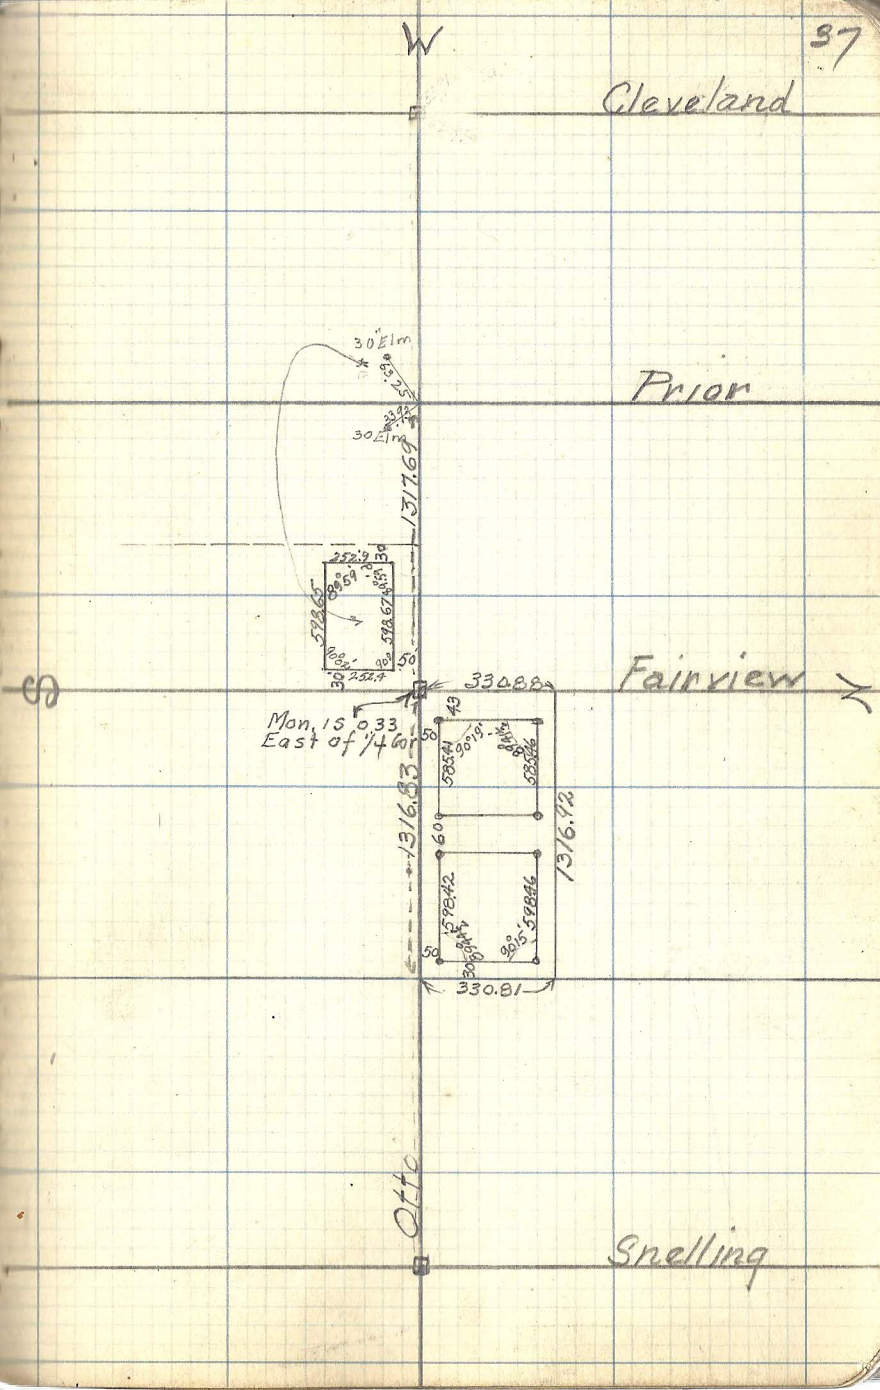
W
Cleveland
Prior
Fairview
Snelling
30 Elm
30 Elm
1317.69
330.88
Mon. 18 033
East of 1/4 Cor
1316.83
1316.12
330.81
50
60
50
43