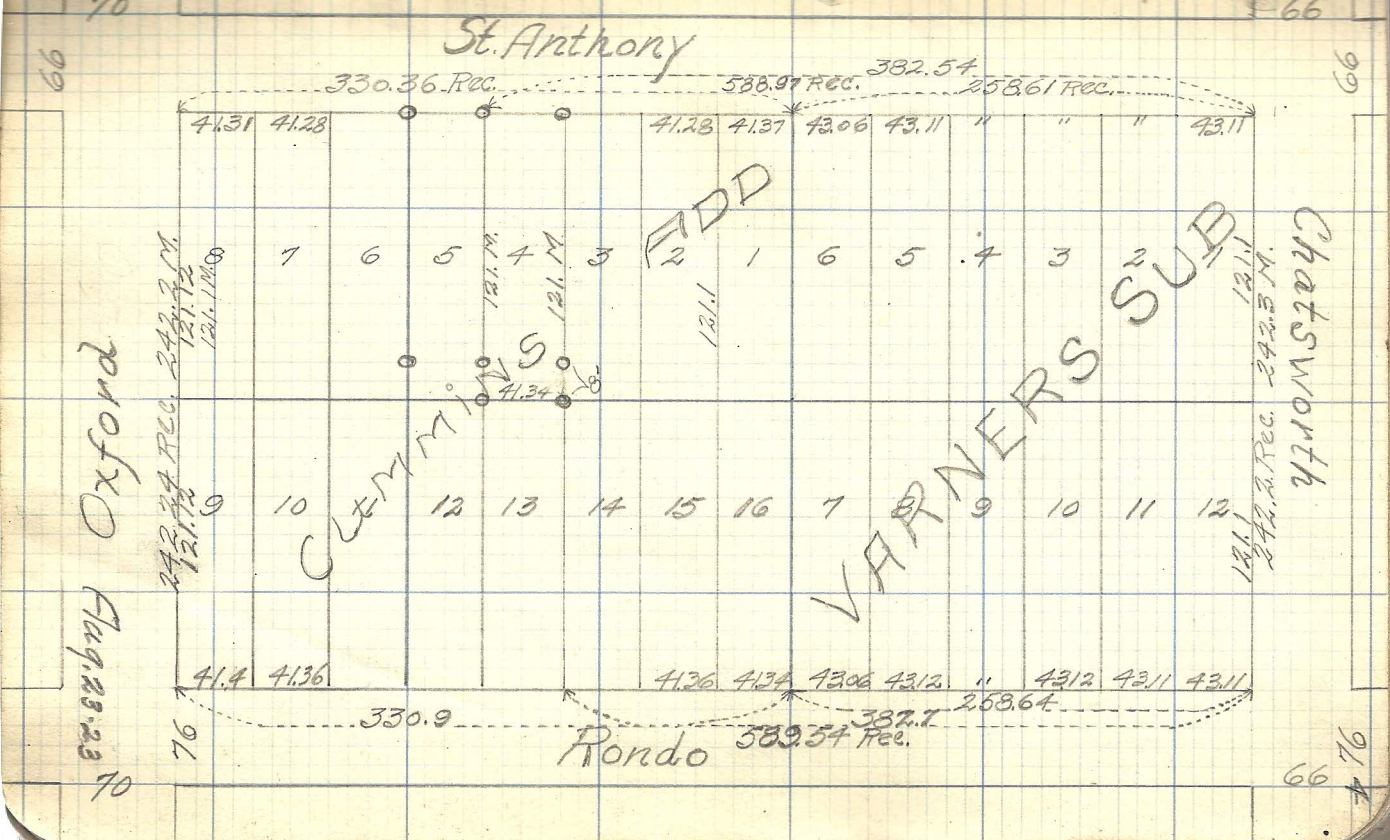
St. Anthony
330.36 Rec.
388.97 Rec.
382.54
258.61 Rec.
41.31
41.28
41.28
41.37
43.06
43.11
43.11
FDD
CUMMINGS
VARNERS SUB
Oxford
Rondo
330.9
382.7
388.54 Rec.
258.64
41.4
41.36
41.36
41.34
43.06
43.12
43.12
43.11
43.11