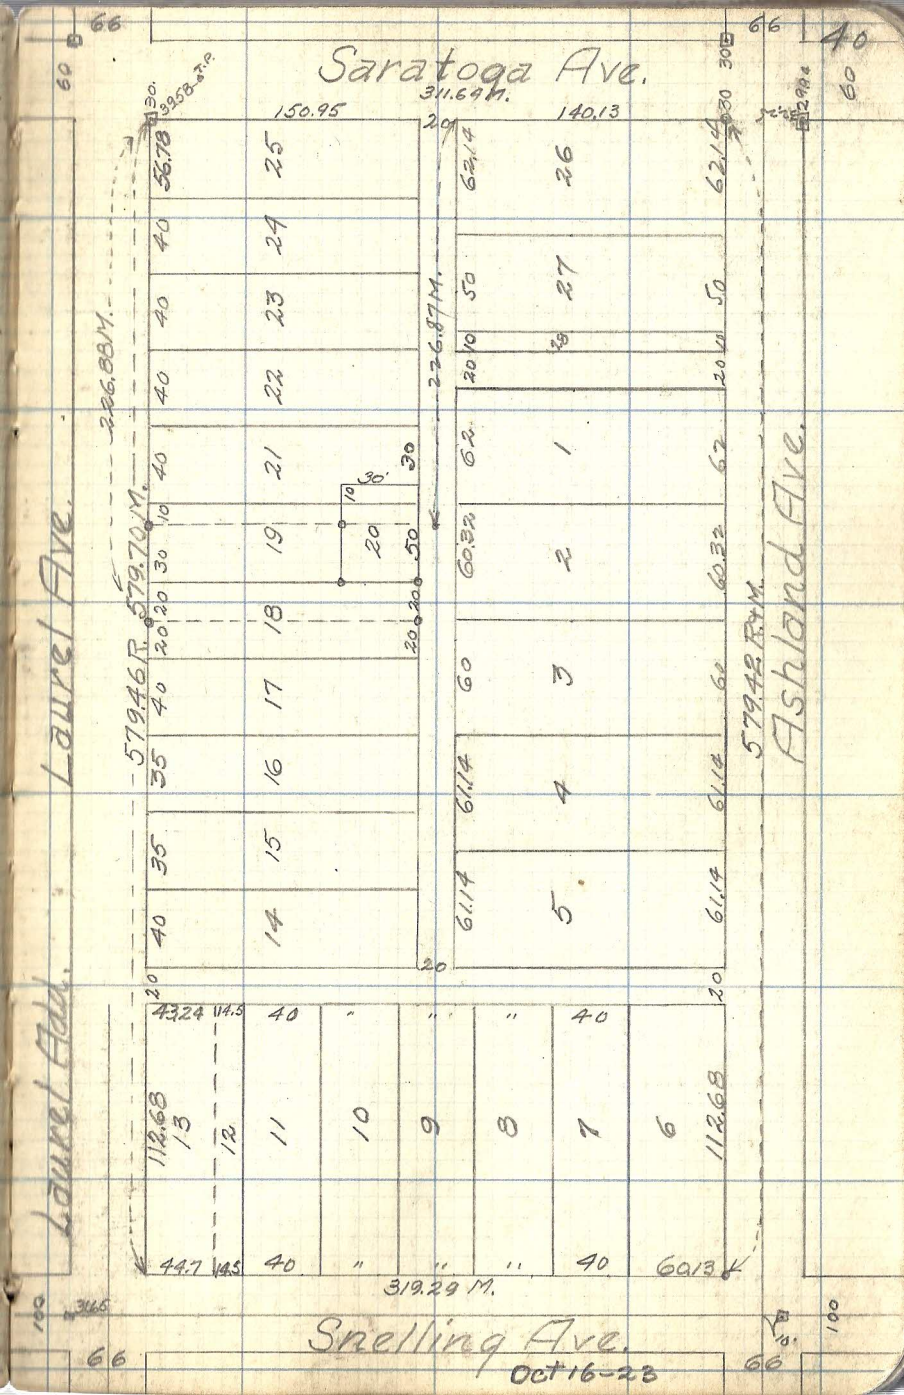
Saratoga Ave.
311.64 M.
150.95
140.13
Laurel Ave.
Ashland Ave.
226.88 M.
579.46 R.
579.70 M.
226.87 M.
579.43 R.M.
Snelling Ave.
319.29 M.
Oct 16-23