



Snelling 2627. R
2625.61 M

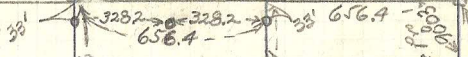

Luhrsen 10 A.
Zibel 95 A.

Leinen 40 A.

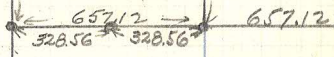

Hunstock 20 A.

2630.44
2629.74 M.

Co. Rd. B

Swansons 80 Acres

2637.08 M.
54 R.

New Brighton

Aug 13-23