


Merrills Div. of Rice St Villas Bk. 5
 Wheelock Parkway

120

Park Ave

42

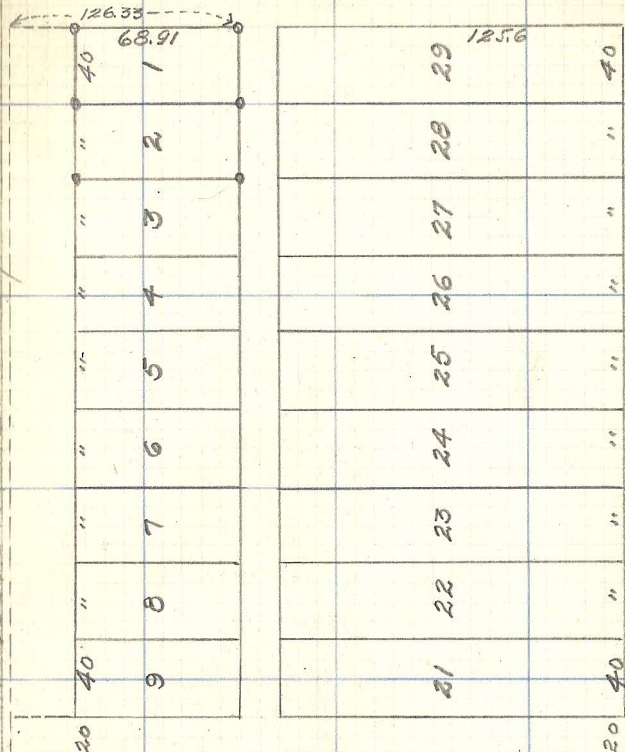

Iowa Ave W.

60

Rice St.

Oct. 22-23

61

S. H. Hoy

120