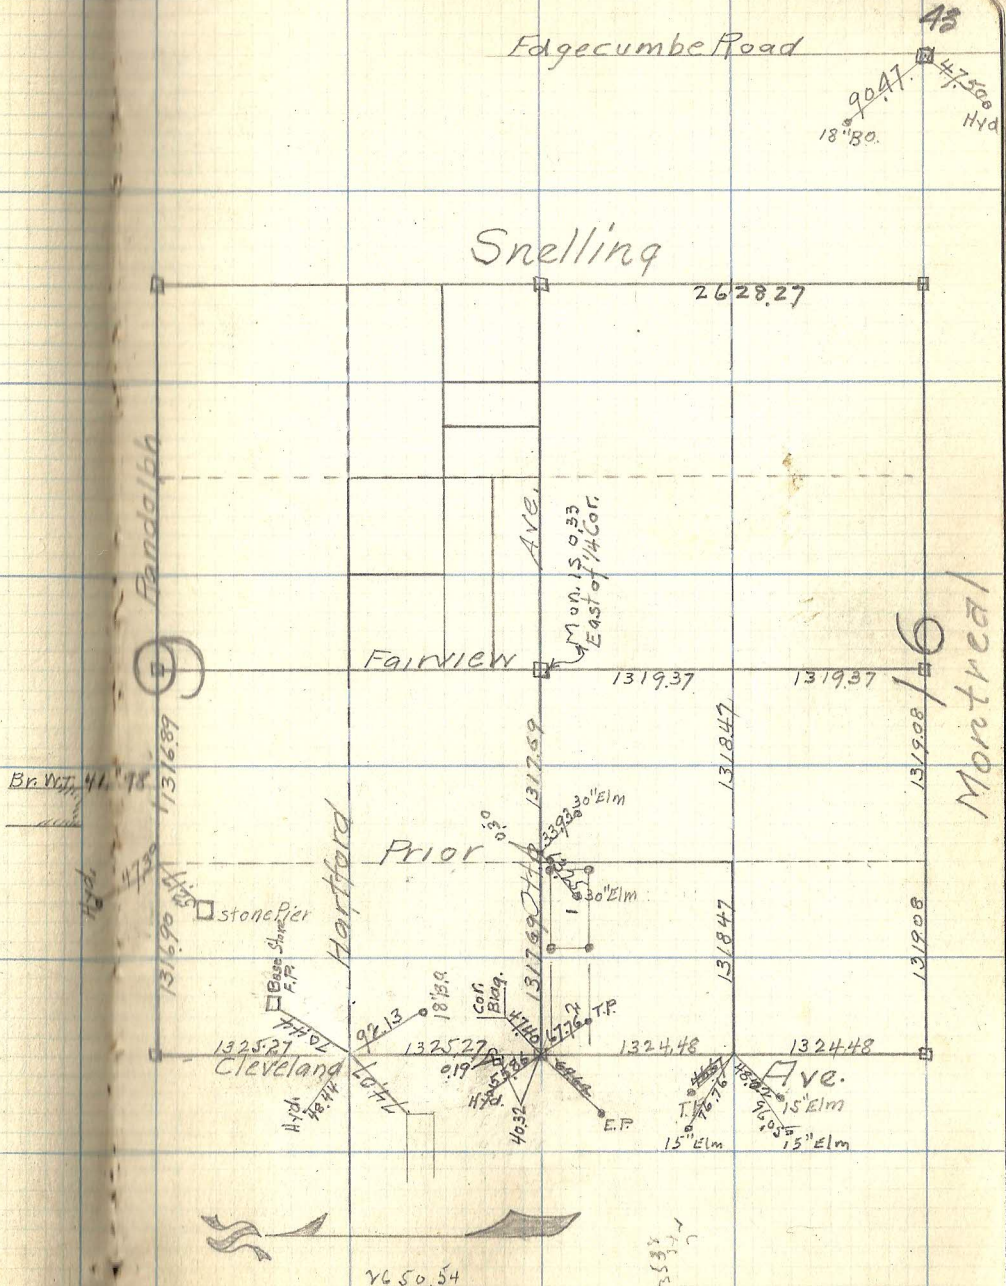
Edgecumbe Road
90.47
47.50
Hyd
18" B.O.
Snelling
2628.27
Randolph
Ave.
Mon. 15 0.33
East of 1/4 Cor.
Fairview
1319.37
1319.37
16
Montreal
1316.89
1317.69
1318.47
1319.08
Br. W.T.
Prior
30" Elm
30" Elm
Hartford
stone Pier
Base Stone F.P.
1316.90
1317.69
1318.47
1319.08
18" B.O.
Cor. Bldg.
T.P.
1325.27
1325.27
1324.48
1324.48
Cleveland
Ave.
Hyd.
E.P.
T.P.
15" Elm
15" Elm
15" Elm
2650.54