


John J. Kennis Re. Ar. B.K. 1
 Goodrich

Kenneth
 265.65 R

66 44

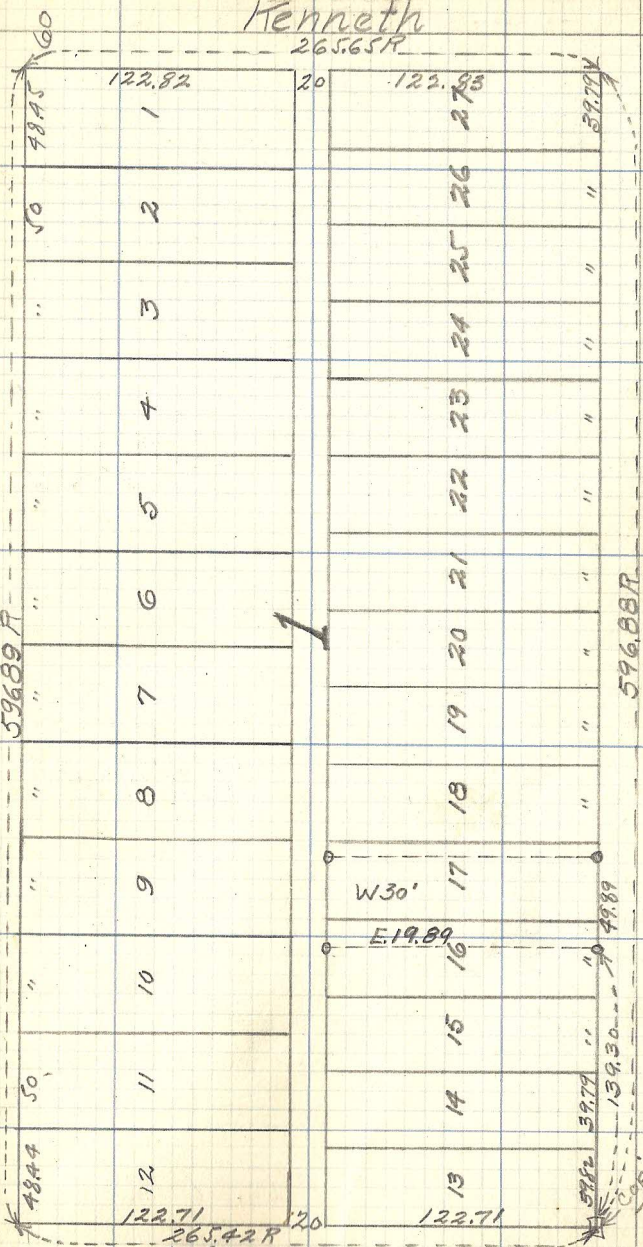

Cleveland

596.88 R
 Fairmount

66
 66

66
 66