


60

# Fredericka.

271.03 M.

270.83 R.

60  
Macalester Add. 2nd Add  
Wellesley  
Bk. 3  
295.9 M

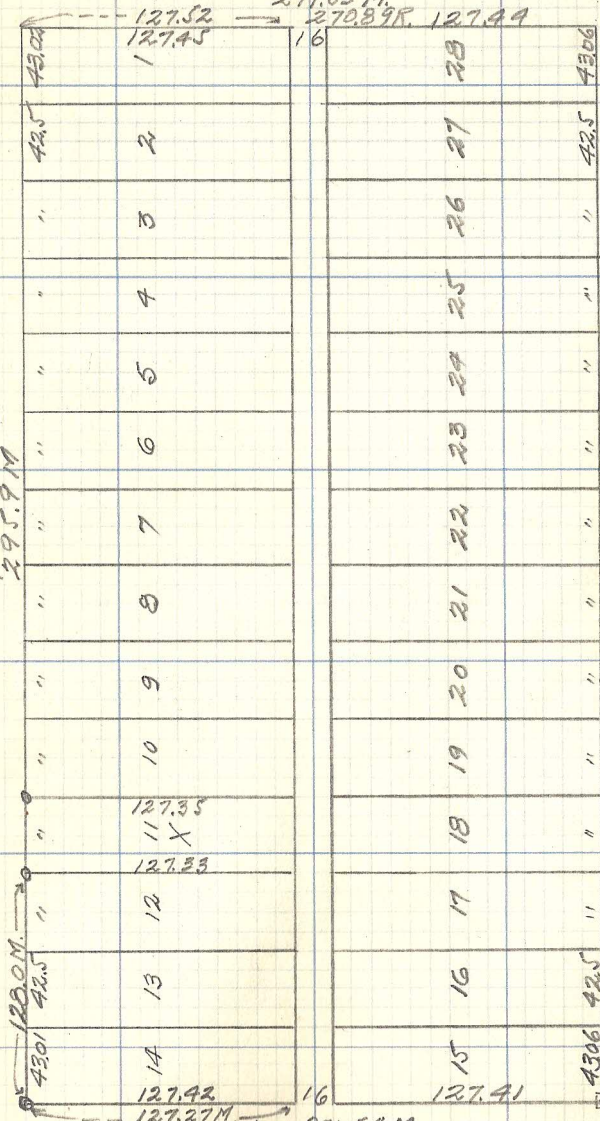

127.42  
127.27 M.

16

127.41

270.54 M.

# Fairview 270.83 R

60

Jefferson

66

60