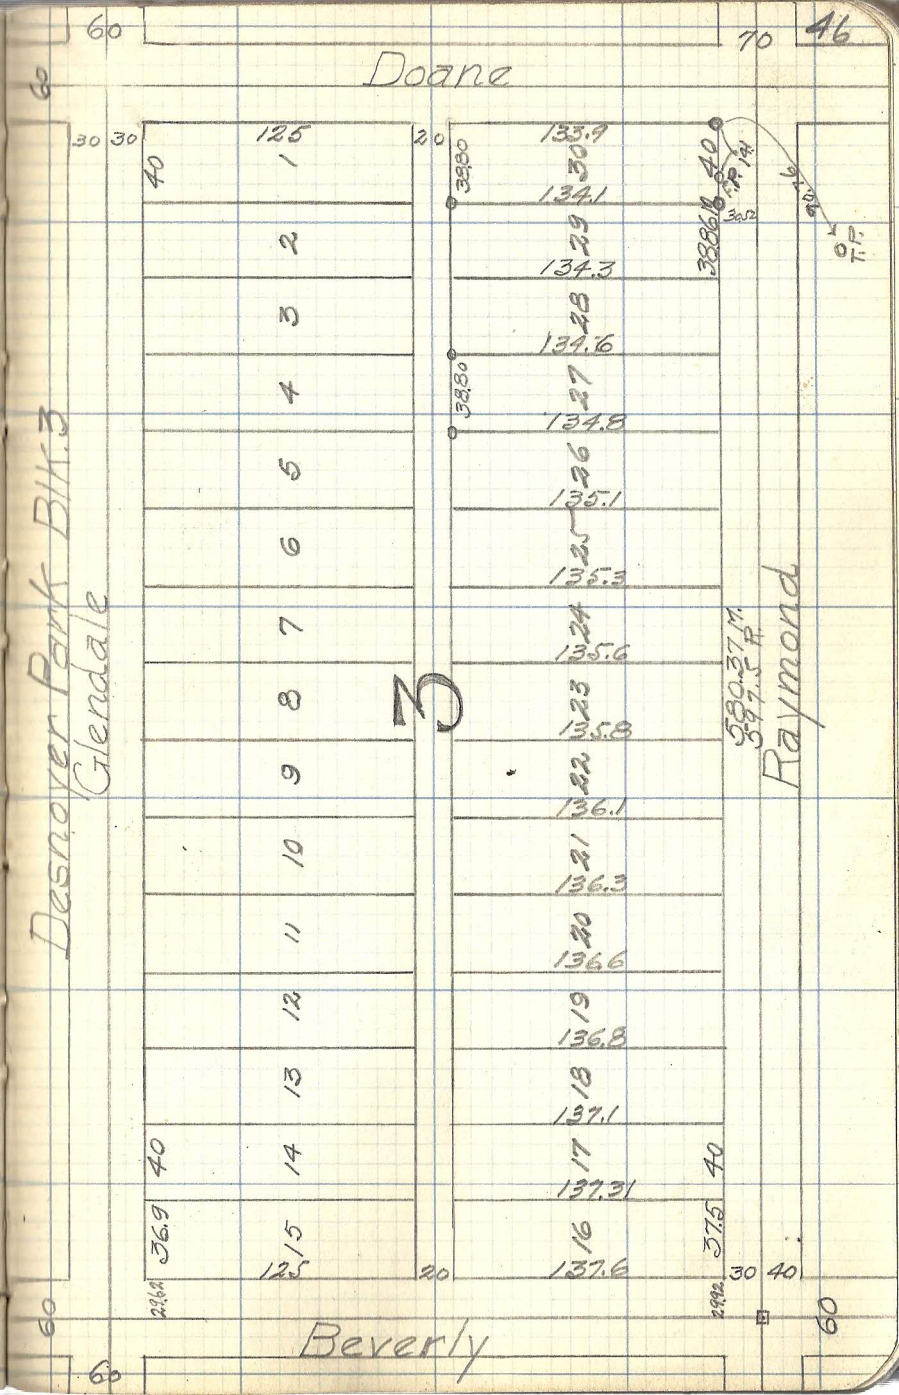

46
60
70
Doane
Desnoyer Park Blk. 3
Glendale
Raymond
Beverly
3
125
133.9
134.1
134.3
134.6
134.8
135.1
135.3
135.6
135.8
136.1
136.3
136.6
136.8
137.1
137.31
137.6
38.80
38.86
30.52
580.37 M.
597.5 P.
36.9
37.5
29.62
29.92