Sec. 14-29-23
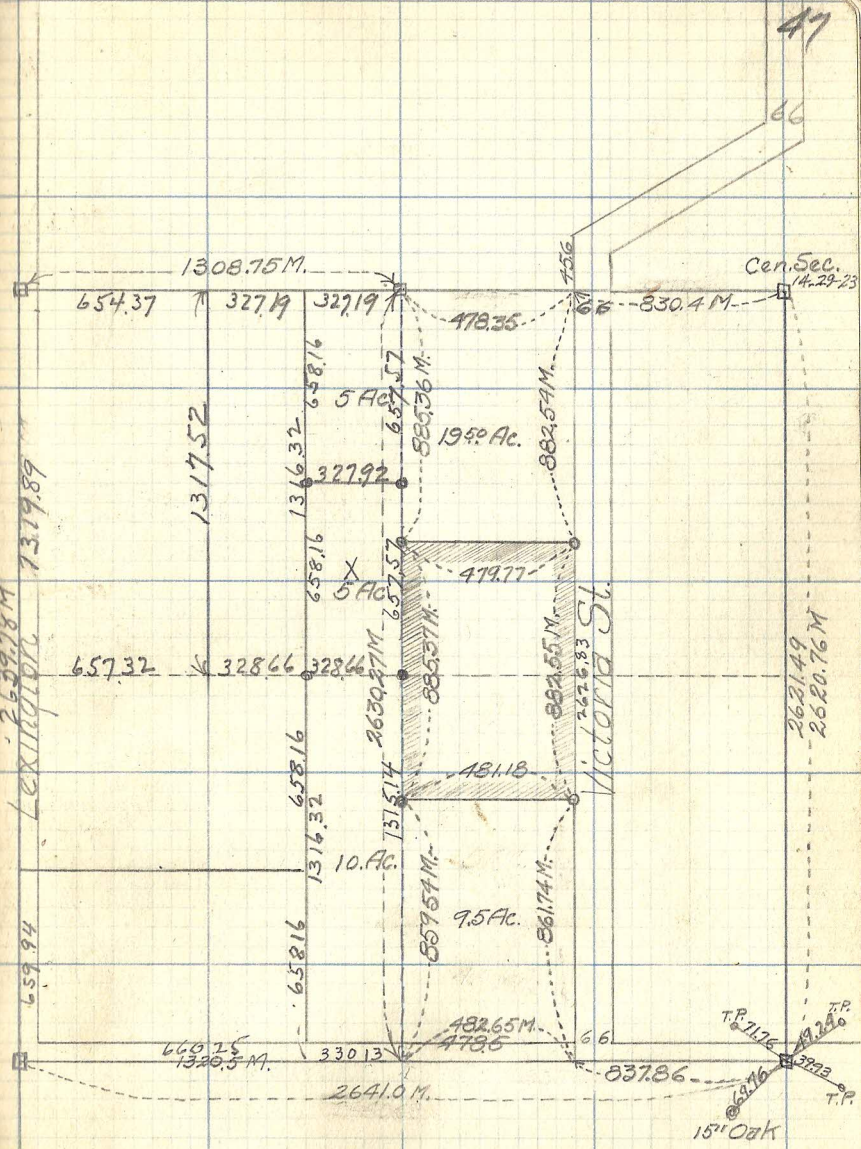
S.W. ¼ of Sec 14