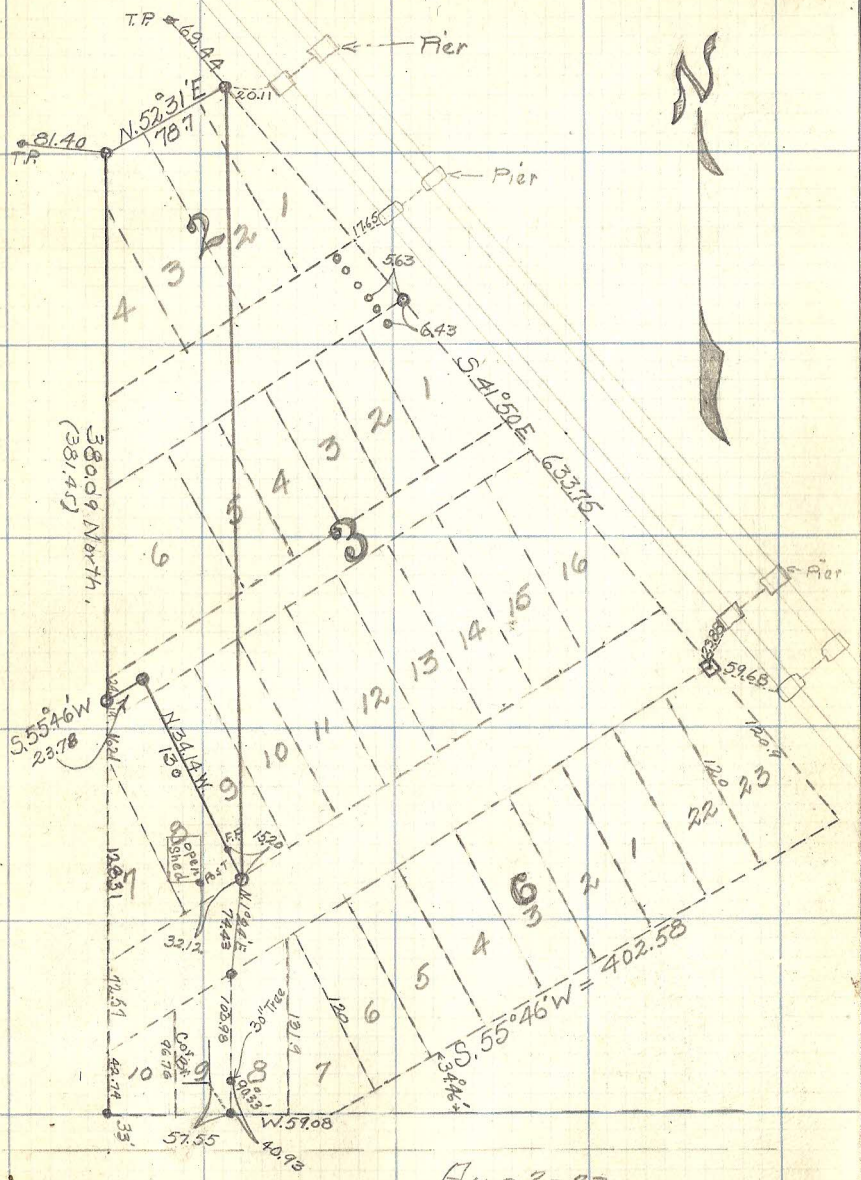
T.P. 69.44
Pier
20.11
N.52°31'E
78.7
81.40
T.P.
Pier
17.65
5.63
6.43
S.41°50'E
633.75
380.09 North.
(381.45)
Pier
59.68
S.55°46'W
23.78
N.34°14'W
130
F.P.
15.20
Open Shed
Post
32.12
N.1°24'E
74.43
S.55°46'W = 402.58
34.46'
30" Tree
103.98
131.9
120
120.9
120
42.74
33'
57.55
40.93
W.59.08
90.33'
Cor. Gr.
96.76
Aug 2-23