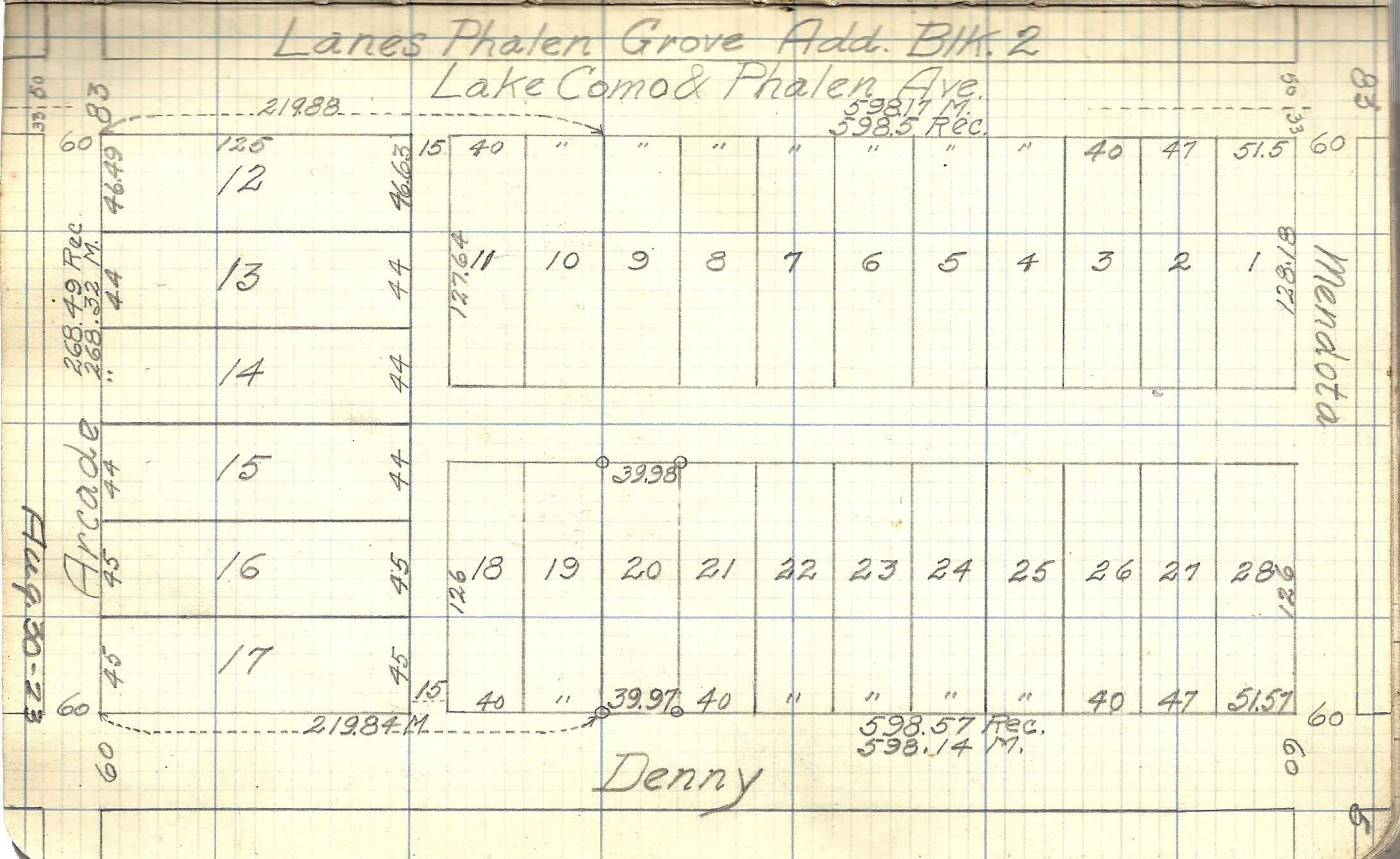Lanes Phalen Grove Add. Blk. 2