


Lincoln

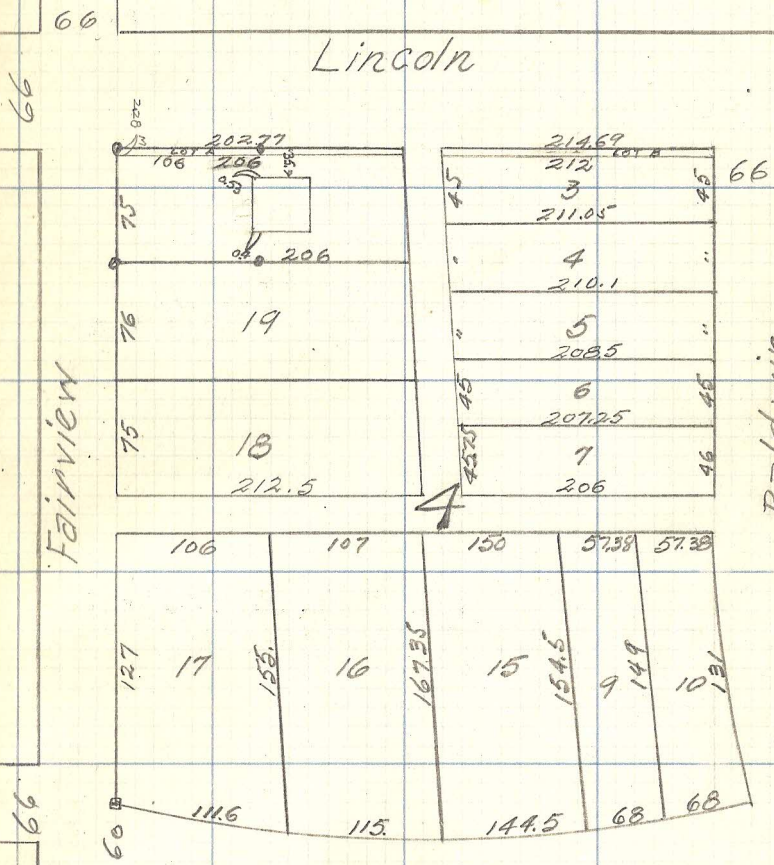

Goodrich

The West 106ft.
 Dyers Re. BIK.4
 of Part of Mac. Park.