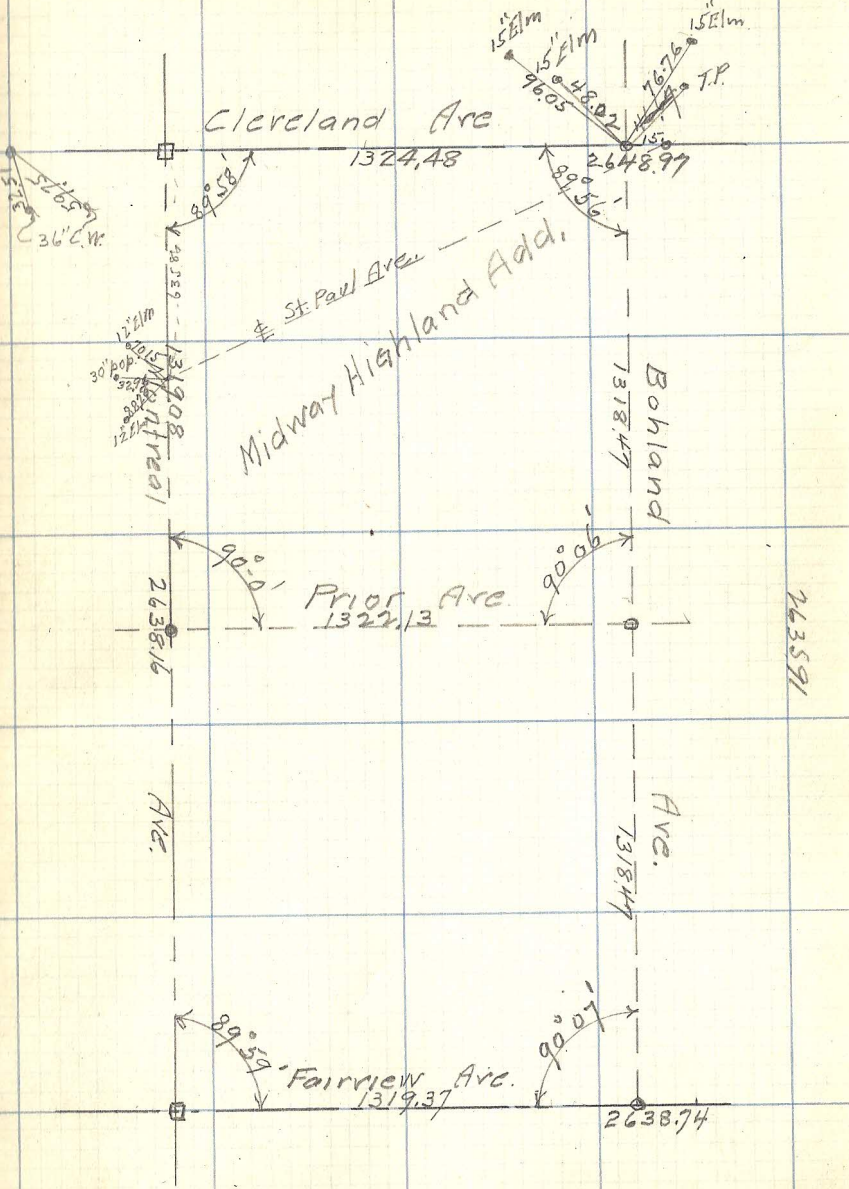
15" Elm
15" Elm
15" Elm
96.05
48.02
76.76
T.P.
Cleveland Ave
1324.48
2648.97
89°58'
89°56'
36" C.W.
℄ St. Paul Ave.
Midway Highland Add.
12" Elm
30" pop.
1319.08
Montreal
Bohland
1318.47
90°0'
90°06'
Prior Ave.
1322.13
2638.16
263591
Ave.
Ave.
1318.47
89°59'
90°07'
Fairview Ave.
1319.37
2638.74