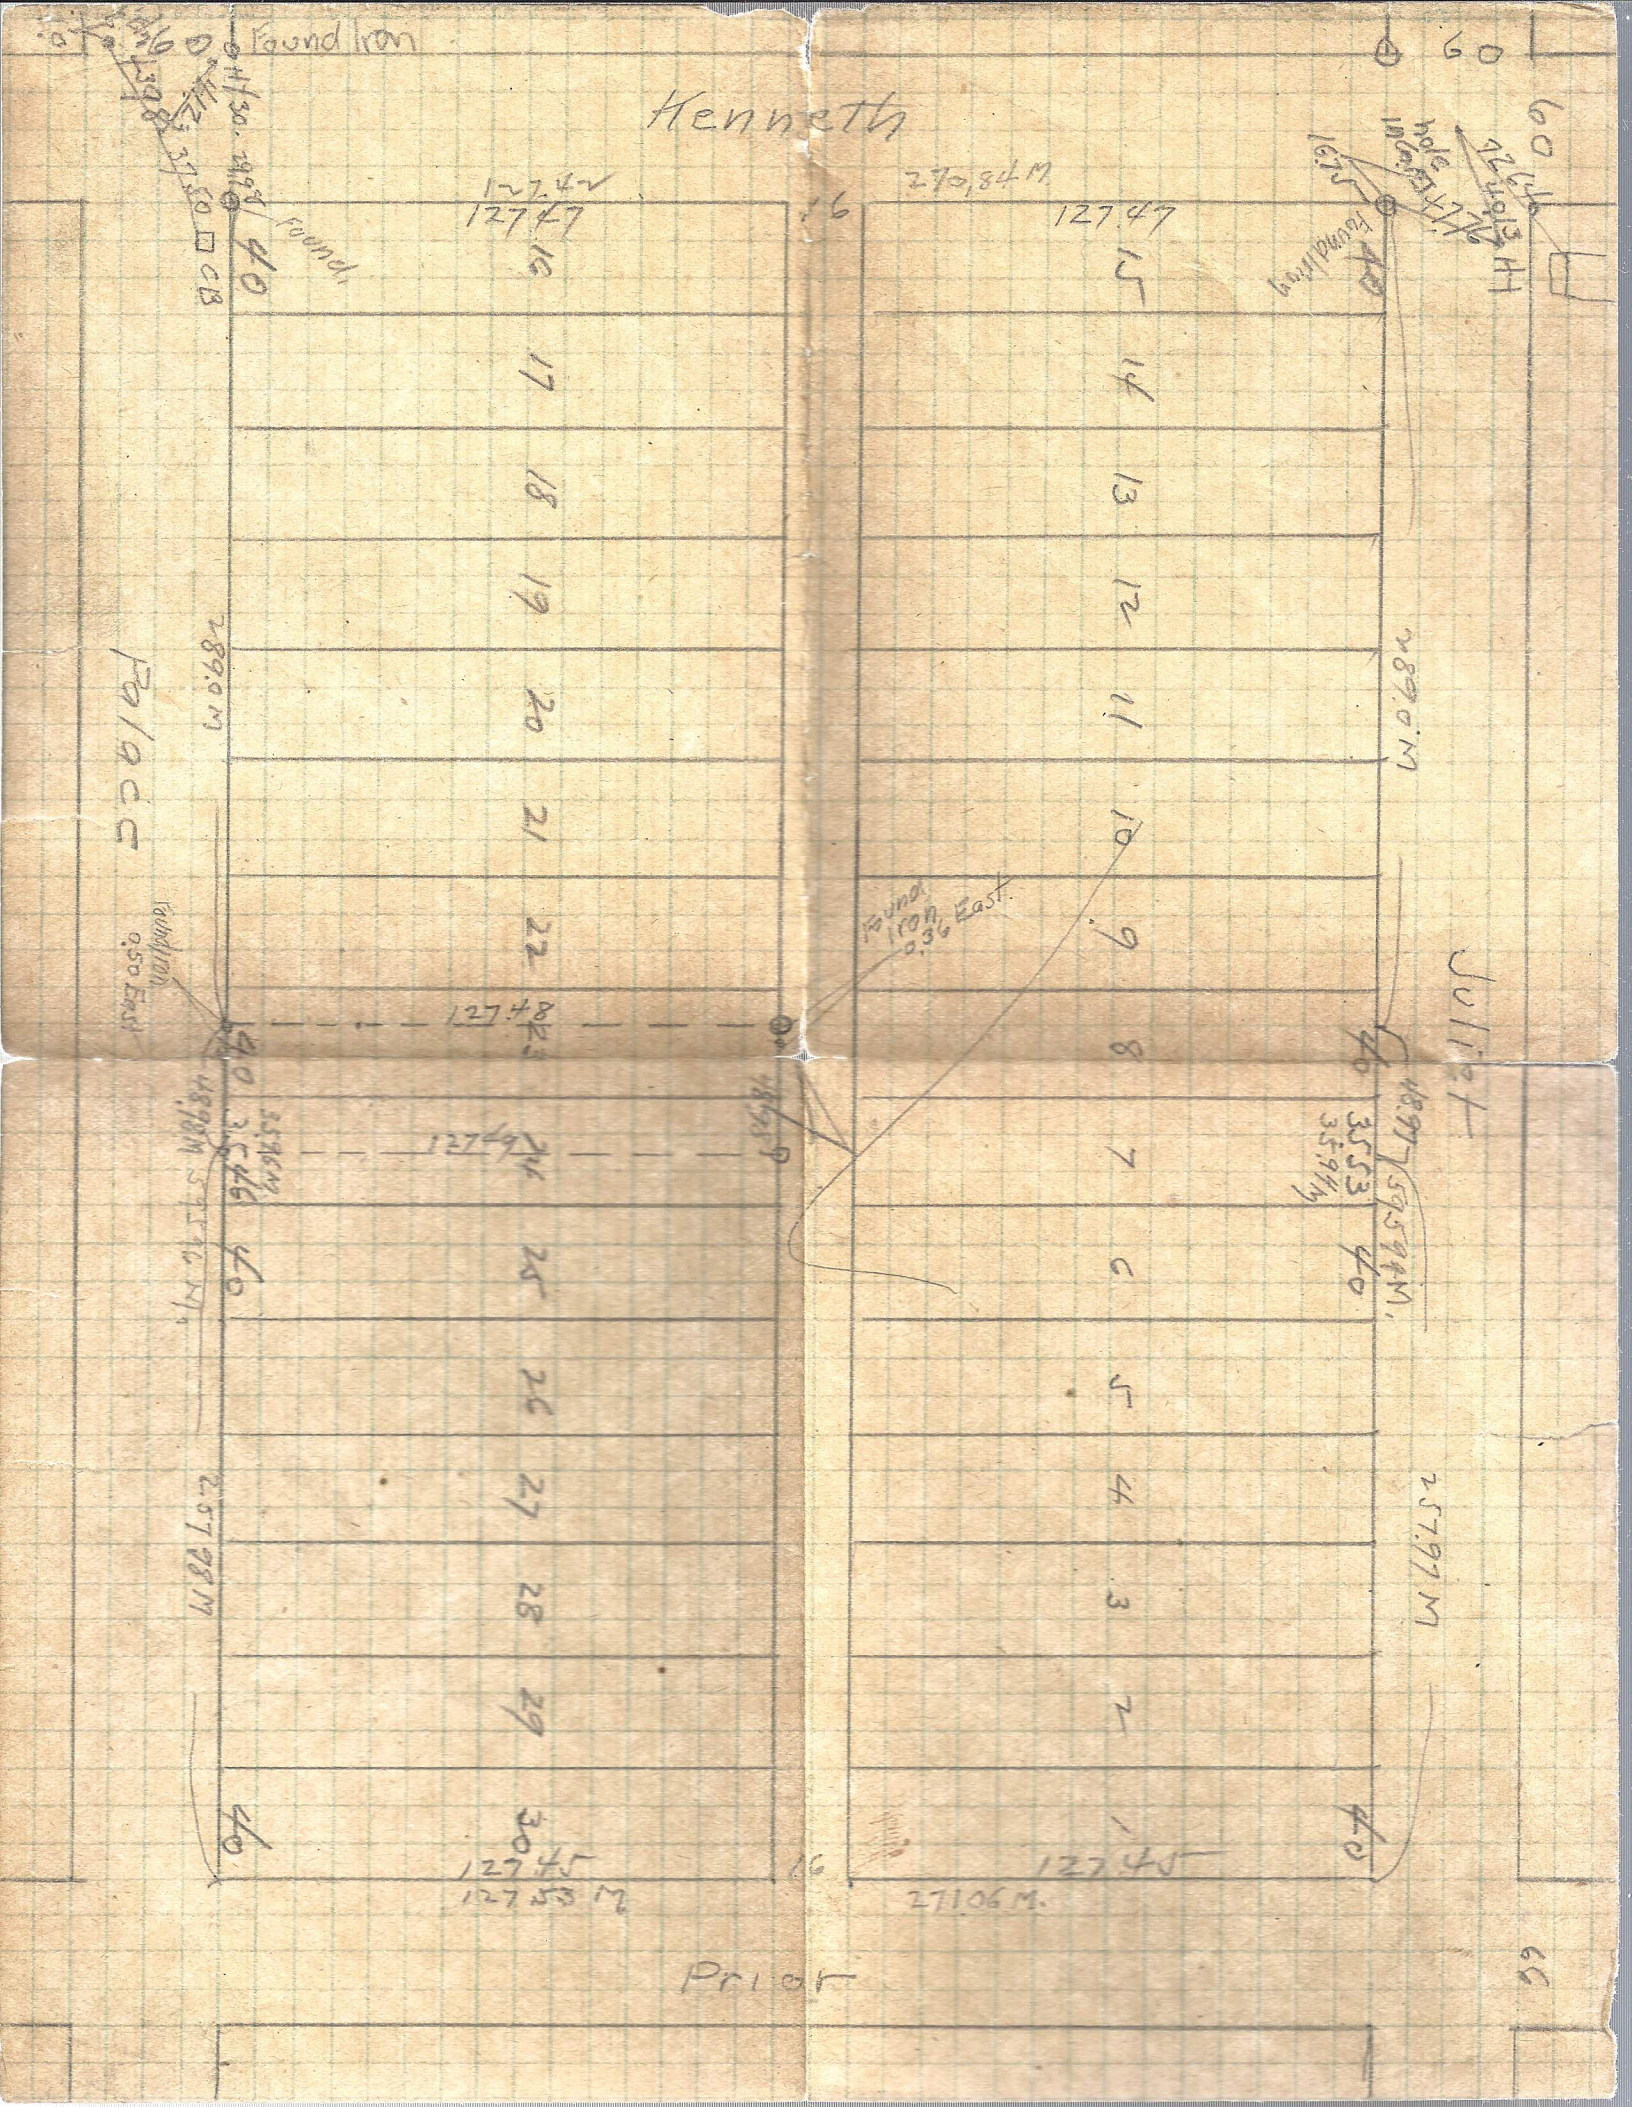
Found Iron
Kenneth
Found
Found Iron
Found Iron 0.36 East
Found Iron 0.50 East
Julian
Prior
127.47
127.45
127.53 M
27.06 M.
270.84 M
N 89° 0 M
S 89° 0 M
N 89° 57' 30" W
S 89° 57' 30" W
35.53
35.49
35.46
35.43
1.27
1.21
1.12
1.07
1
2
3
4
5
6
7
8
9
10
11
12
13
14
15
16
17
18
19
20
21
22
23
24
25
26
27
28
29
30
60
66