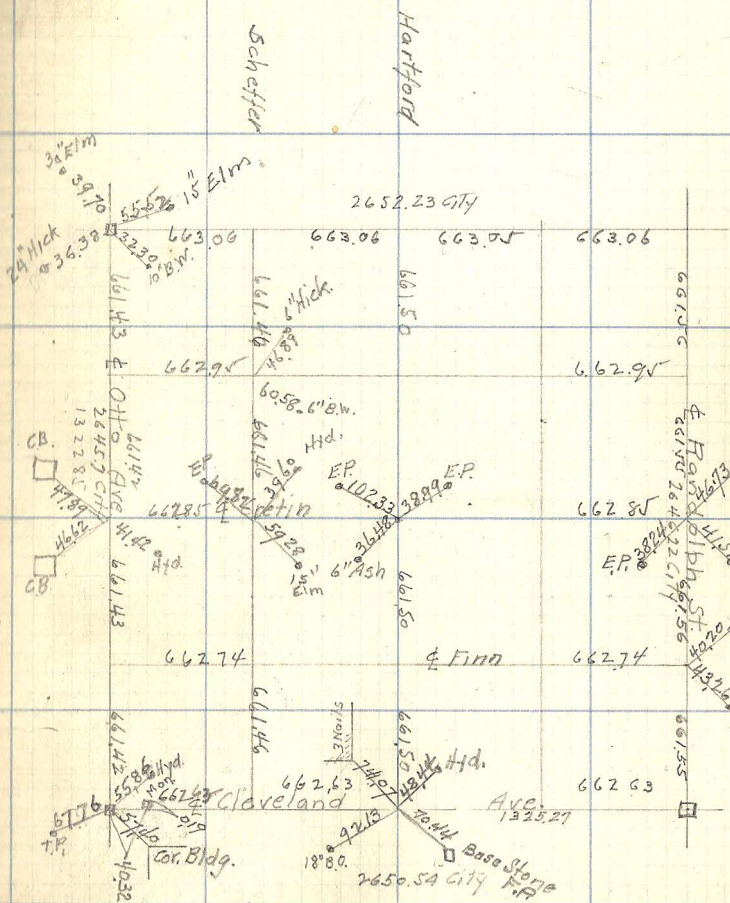
Schaffer
Hartford
2652.23 City
663.06
663.06
663.05
663.06
24" Hick
36.38
15" Elm
10" B.W.
6" Hick
661.43
661.46
661.50
661.56
662.95
662.95
60.58 6" B.W.
℄ Otto Ave
℄ Randolph St.
℄ Cretin
℄ Finn
℄ Cleveland Ave.
1325.27
662.85
662.85
662.74
662.74
662.63
662.63
CB.
CB
Hyd.
E.P.
6" Ash
15" Elm
Cor. Bldg.
Base Stone F.P.
2650.54 City
18" B.O.
T.P.