

80


60

54

Cambridge Ave.

Elmer & Morrison's Pl. At.

Grand Ave.

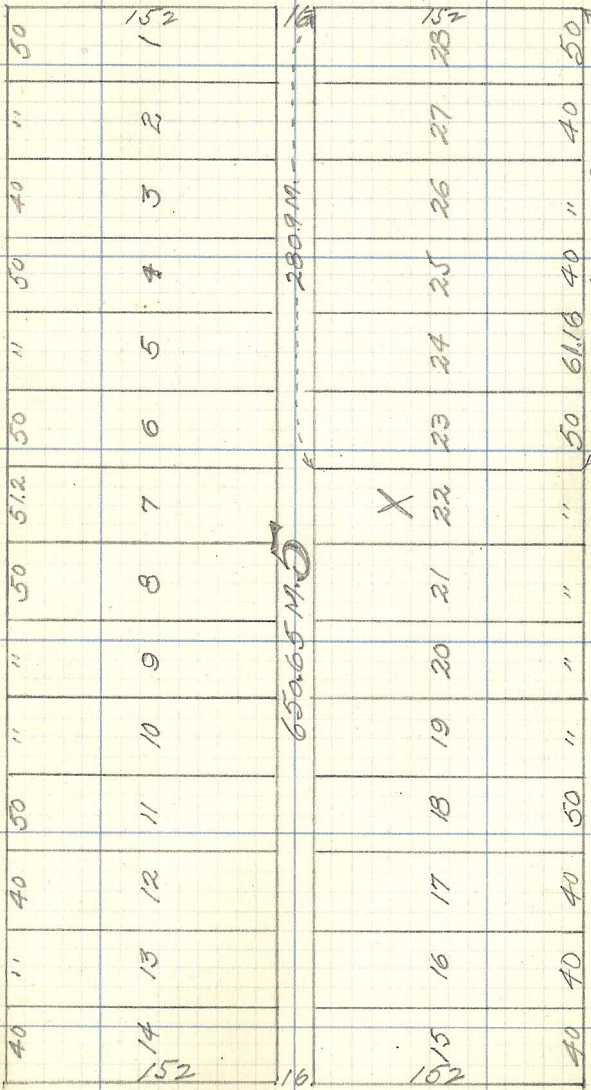

60

Baldwin.

80

60

General St. 60