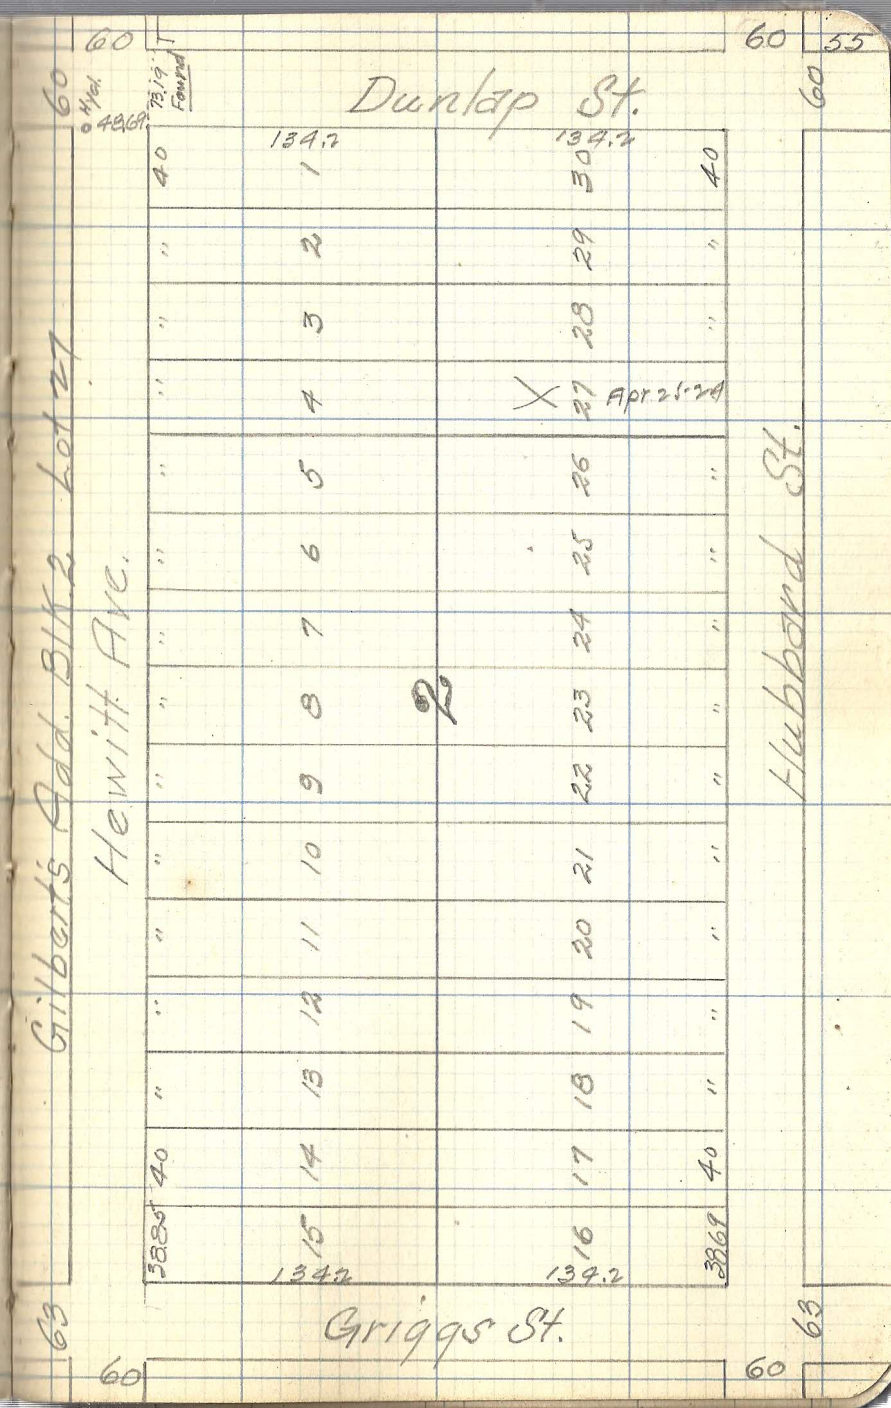
Dunlap St.
Hewitt Ave.
Hubbard St.
Griggs St.
Gilbert's Add. Blk 2. Lot 27
Apr 25-29
134.2
134.2
134.2
134.2
40
40
40
40
2