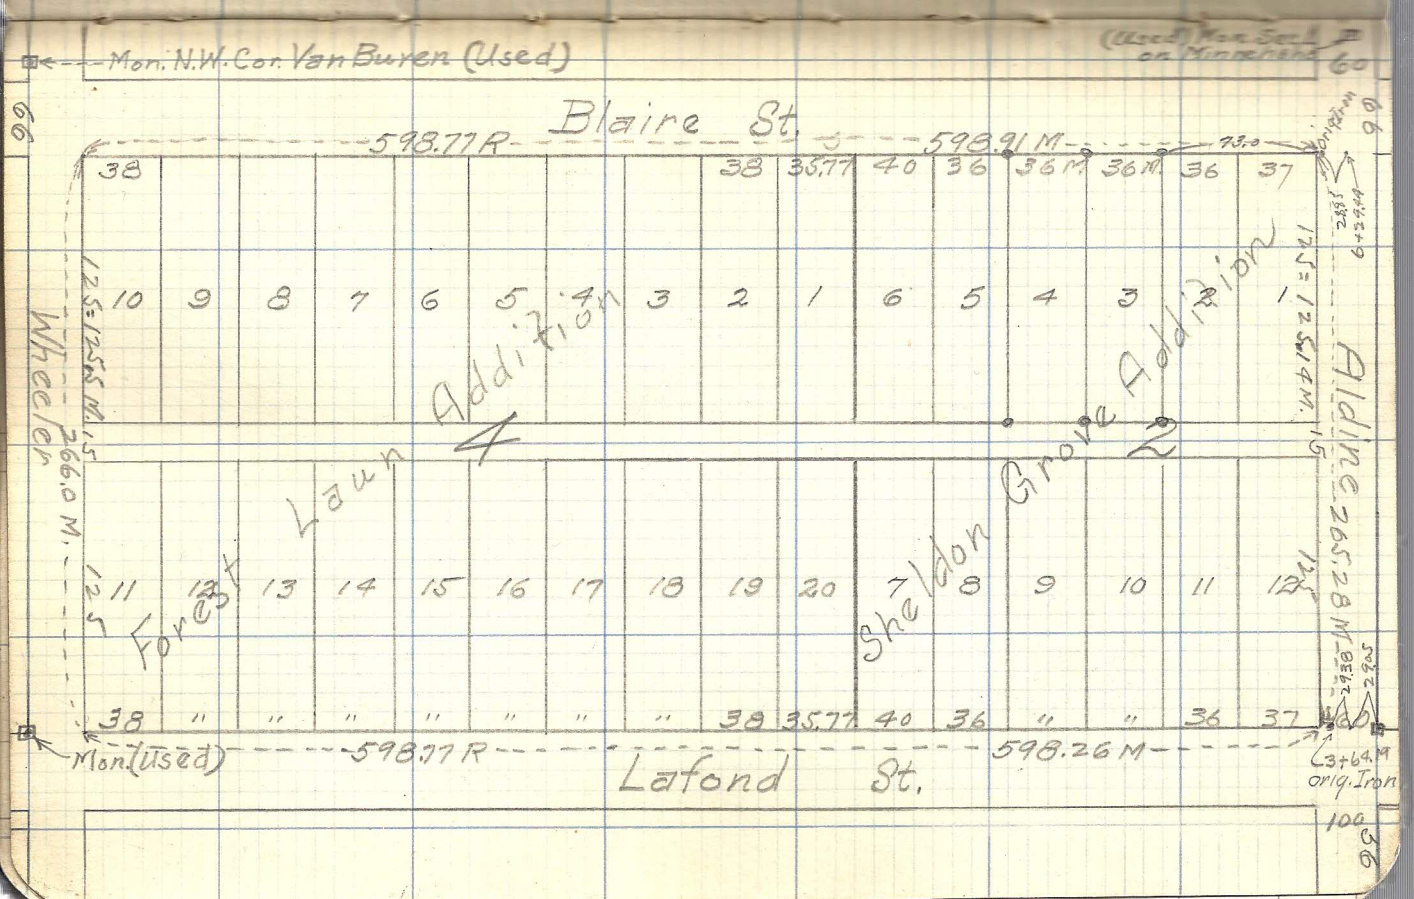

Mon. N.W. Cor. Van Buren (Used)
(Used) Mon. Set on Minnehaha
60
66
Blaire St.
598.77 R
598.91 M
73.0
Orig. Iron
38
38
35.77
40
36
36 M
36 M
36
37
10
9
8
7
6
5
4
3
2
1
6
5
4
3
2
1
125=125.5 M.
125=125.14 M.
Wheeler
266.0 M.
Forest Laun Addition
4
Sheldon Grove Addition
2
Aldine
265.28 M
11
12
13
14
15
16
17
18
19
20
7
8
9
10
11
12
125
38
"
"
"
"
"
"
"
38
35.77
40
36
"
"
36
37
Mon. (Used)
598.77 R
598.26 M
Lafond St.
3+64.19
orig. Iron
100
36