

60

60

Greenwood Ave.


80

80

West St. Paul Proper.

Isabel St. E.

Congress St. E.

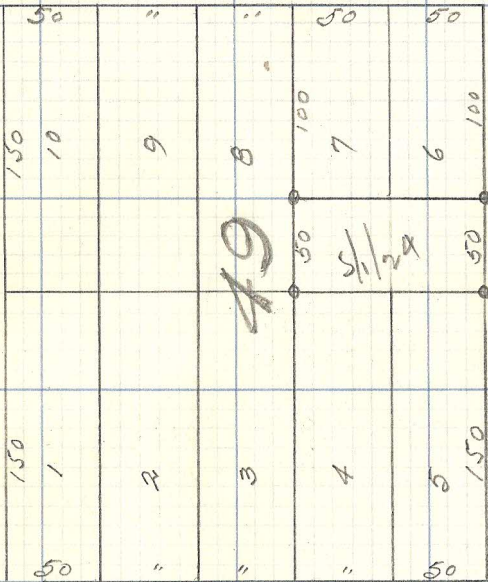

80

80

Clinton Ave.

60

60

