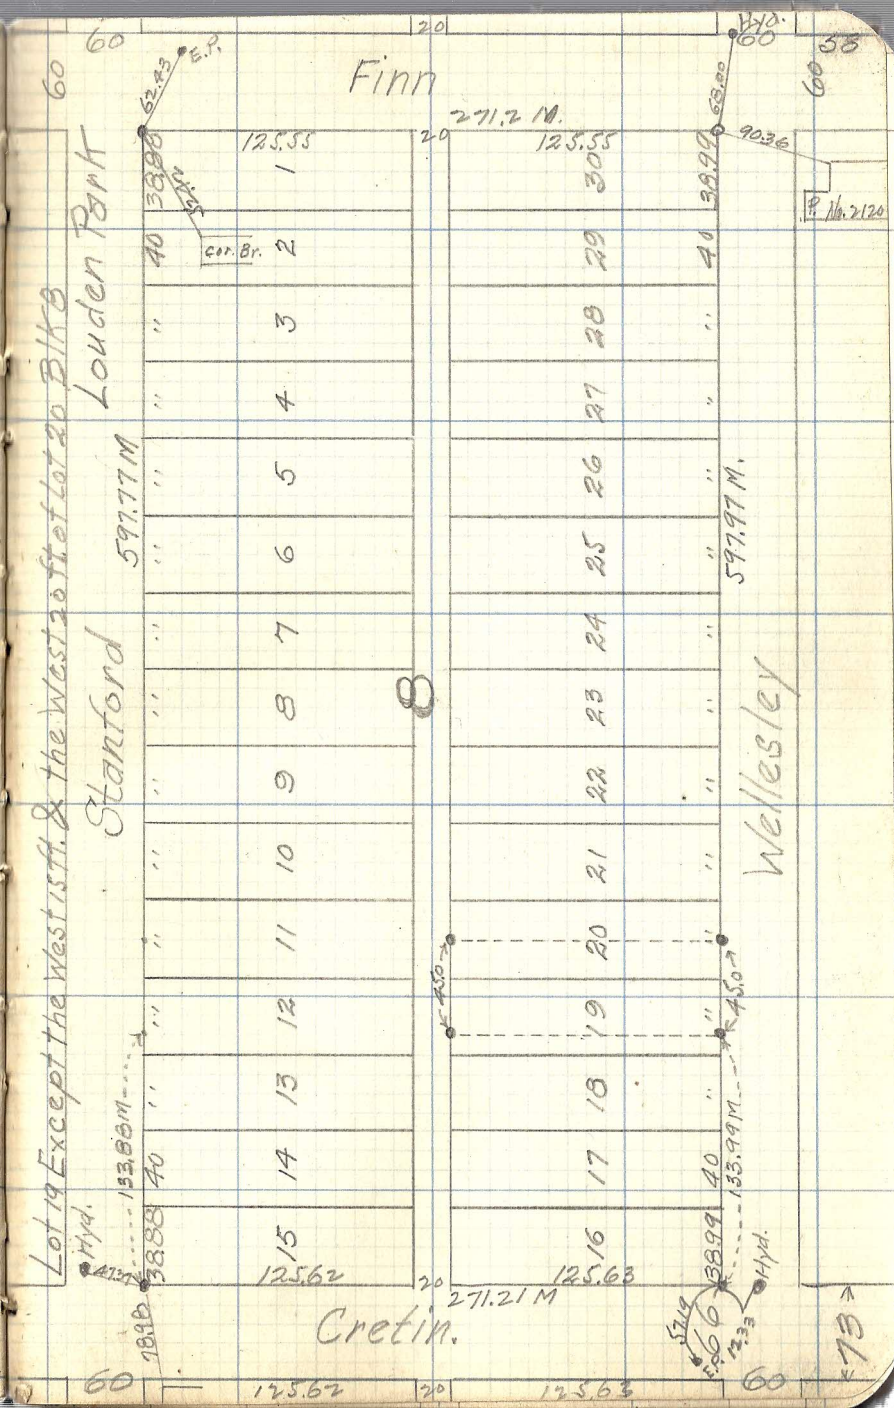
Finn
271.2 M.
Louden Park
Stanford
597.77 M.
Wellesley
597.97 M.
Cretin.
271.21 M
125.55
125.62
125.63
133.66 M.
133.99 M.
450
E.P.
Cor. Br.
Hyd.
Bldg.
60
20
8