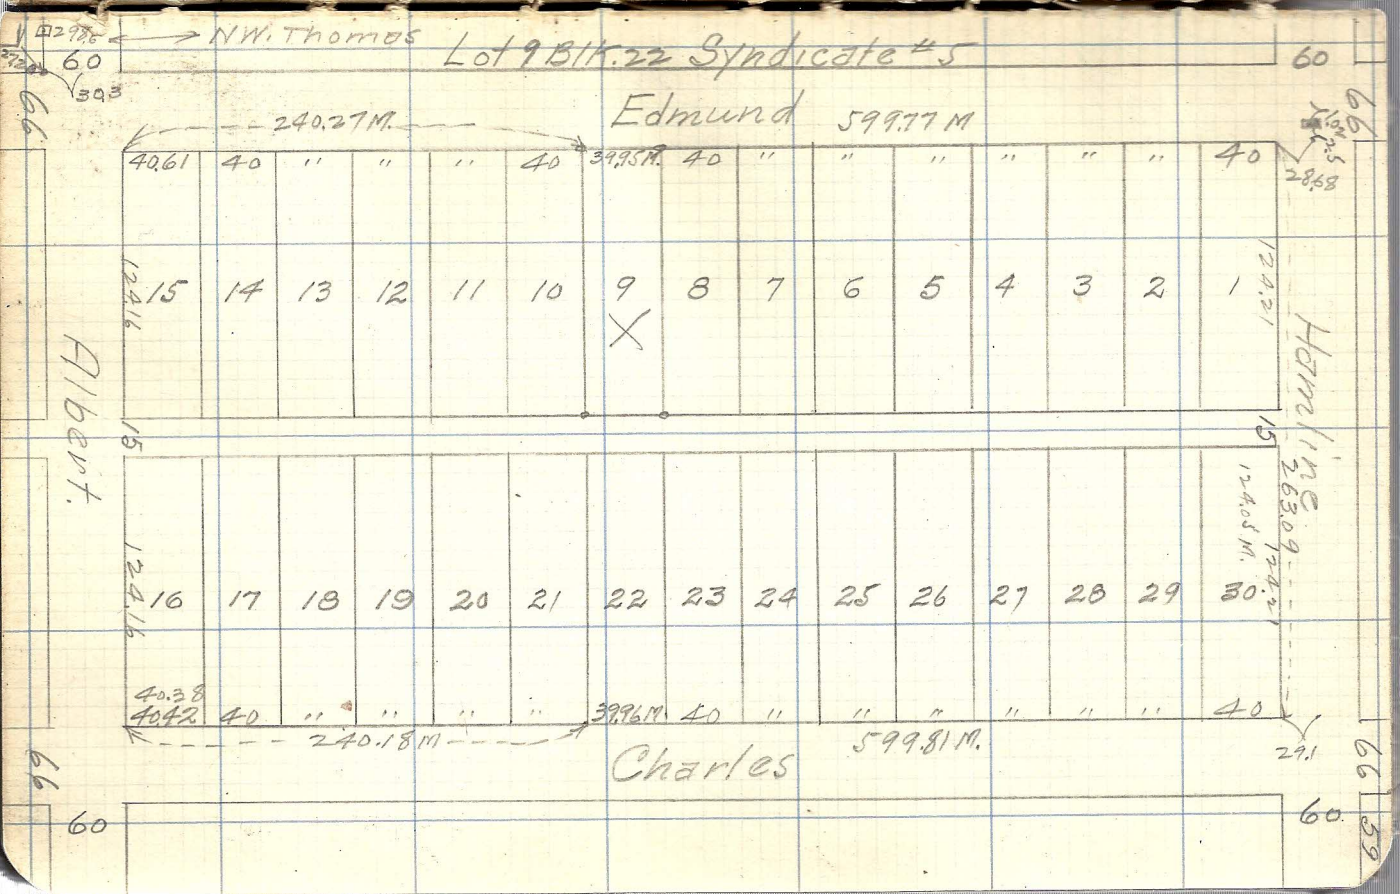
NW. Thomas
Lot 9 Blk. 22 Syndicate #5
60
Edmund
240.27 M.
599.77 M
40.61
40
39.95 M.
28.63
15
14
13
12
11
10
9
8
7
6
5
4
3
2
1
Hamline
263.09
16
17
18
19
20
21
22
23
24
25
26
27
28
29
30
40.38
40.42
39.96 M.
240.18 M.
599.81 M.
29.1
Charles