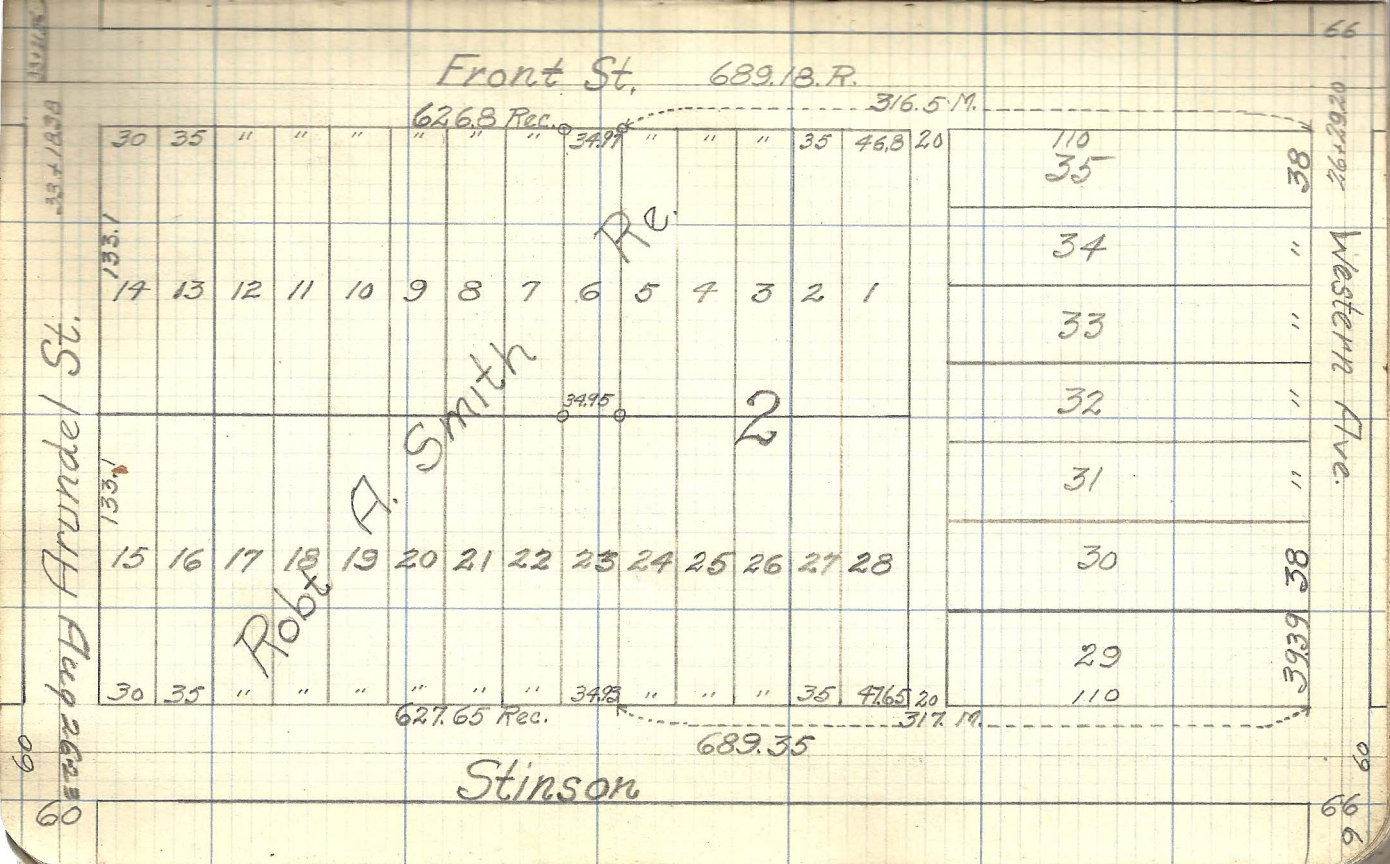
Front St.
689.18 R.
626.8 Rec.
316.5 M.
Western Ave.
Robt A. Smith
Re
2
Aug 26 1922
Stinson
627.65 Rec.
317.10
689.35
133.1
133.1
34.97
34.95
34.93
46.8
47.65
110
35
34
33
32
31
30
29
38
38
39
39
20
20