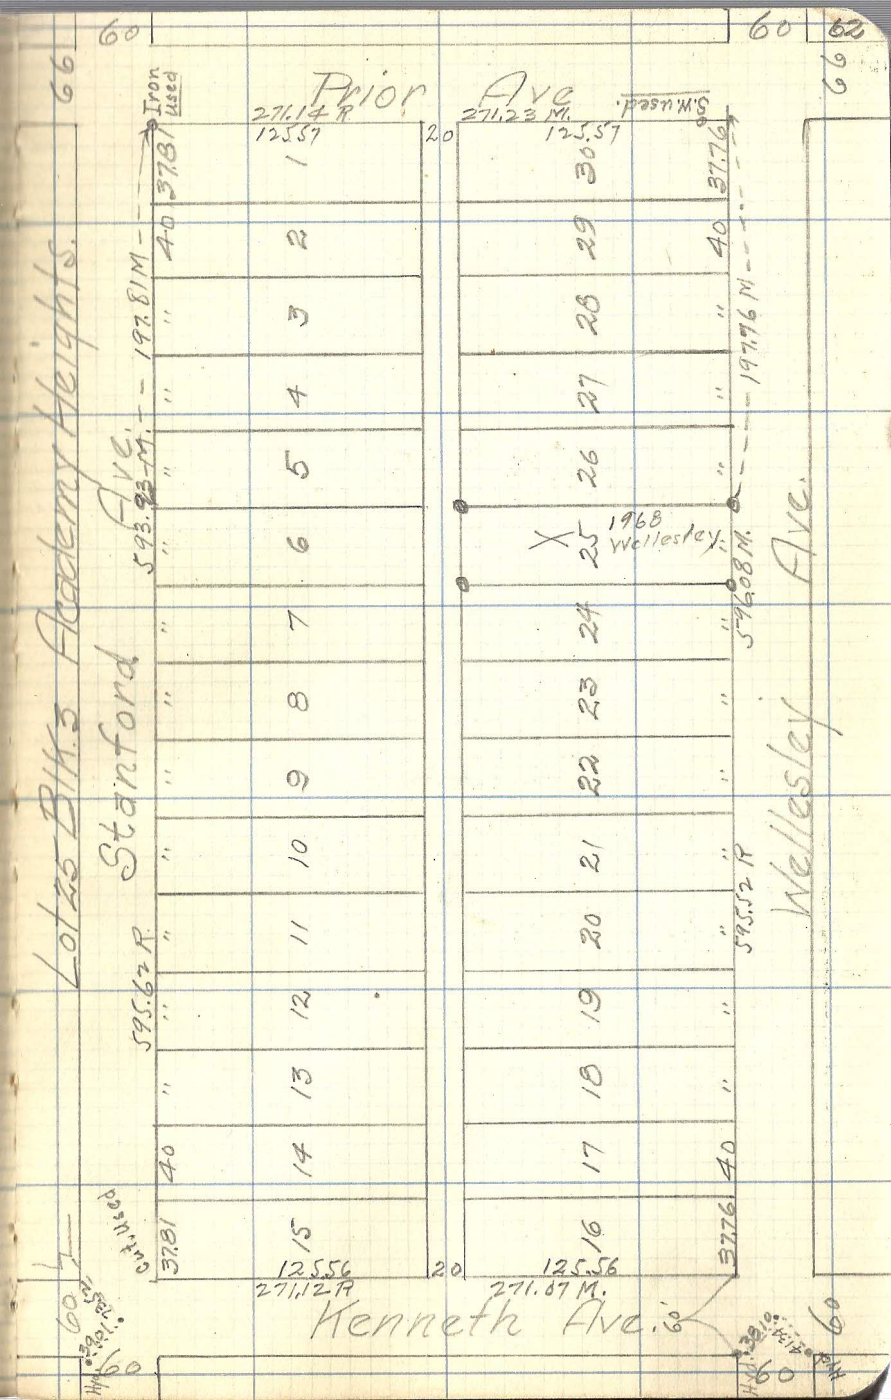

Lot 25 Blk. 3 Academy Heights.
Prior Ave
Stanford Ave.
Wellesley Ave.
Kenneth Ave.
Iron Used
S.W. used
271.14 R
271.23 M.
125.57
125.56
271.12 R
271.07 M.
20
37.81
37.76
40
1
2
3
4
5
6
7
8
9
10
11
12
13
14
15
16
17
18
19
20
21
22
23
24
25
26
27
28
29
30
1968 Wellesley
593.93 M.
197.81 M.
197.76 M.
596.08 M.
595.62 R
595.52 R
Cut Used
60
66
62