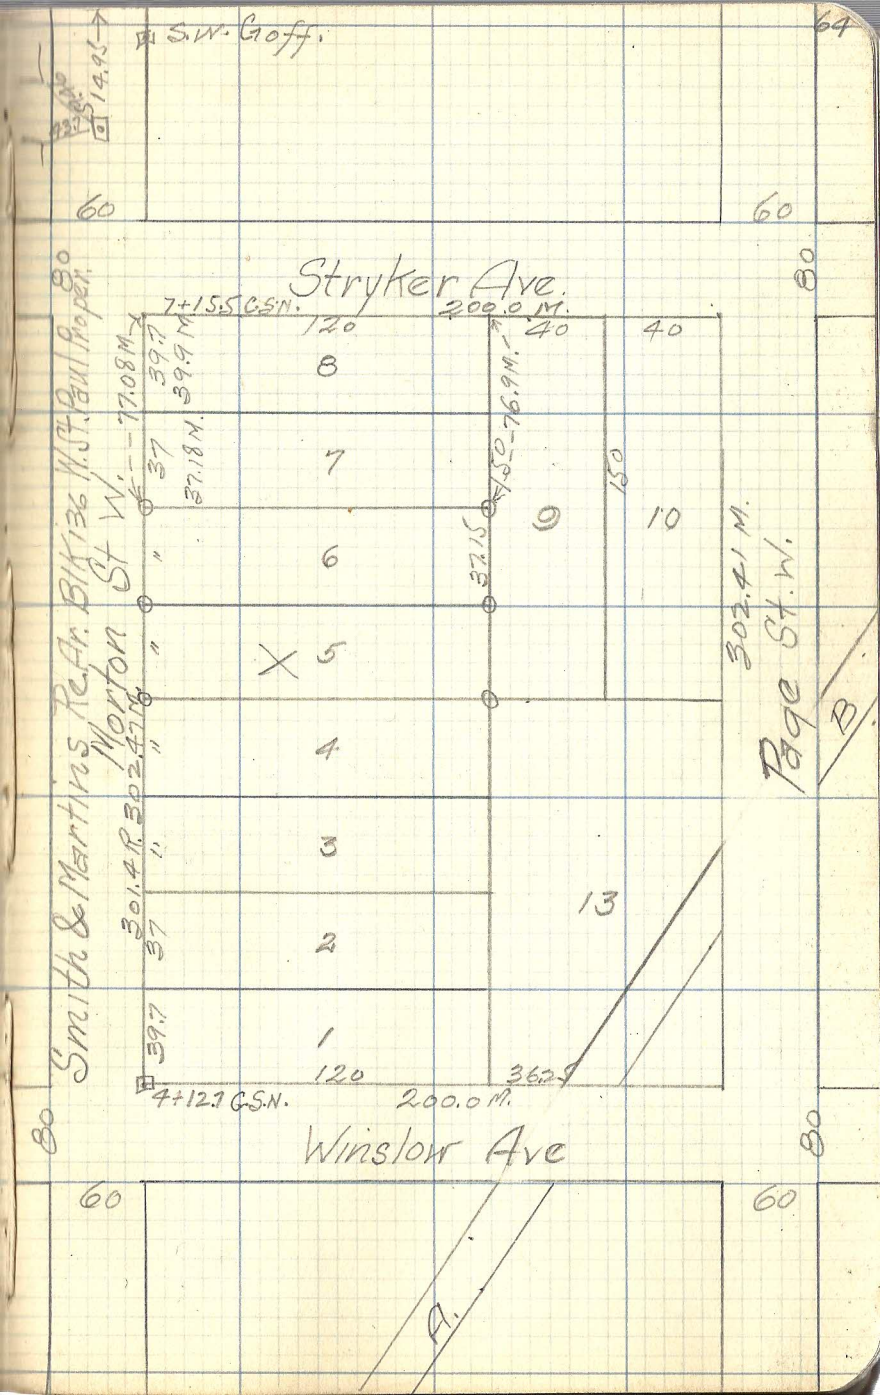
S.W. Goff.
Stryker Ave.
7+15.5 C.S.N.
200.0 M.
120
40
40
8
7
9
10
6
5
4
3
2
1
120
200.0 M.
4+12.1 C.S.N.
Winslow Ave
Morton St. W.
Page St. W.
302.4 M.
301.4 R.
A.
B.
13