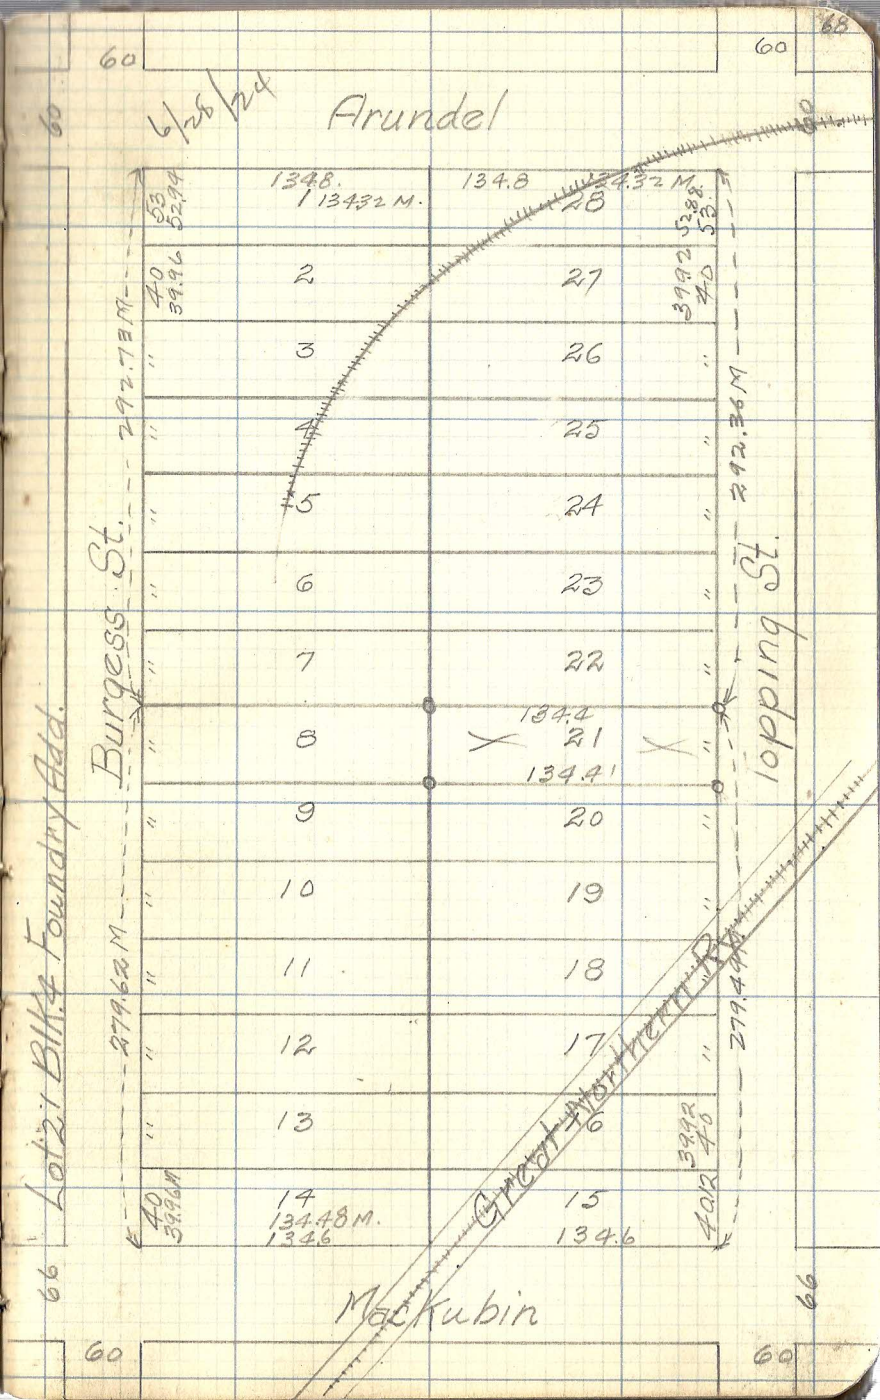
Arundel
Burgess St.
Topping St.
Great Northern R.R.
MacKubin
279.62 M
279.44
134.8
134.32 M
134.8
134.41
134.48 M.
134.6
134.6
134.6