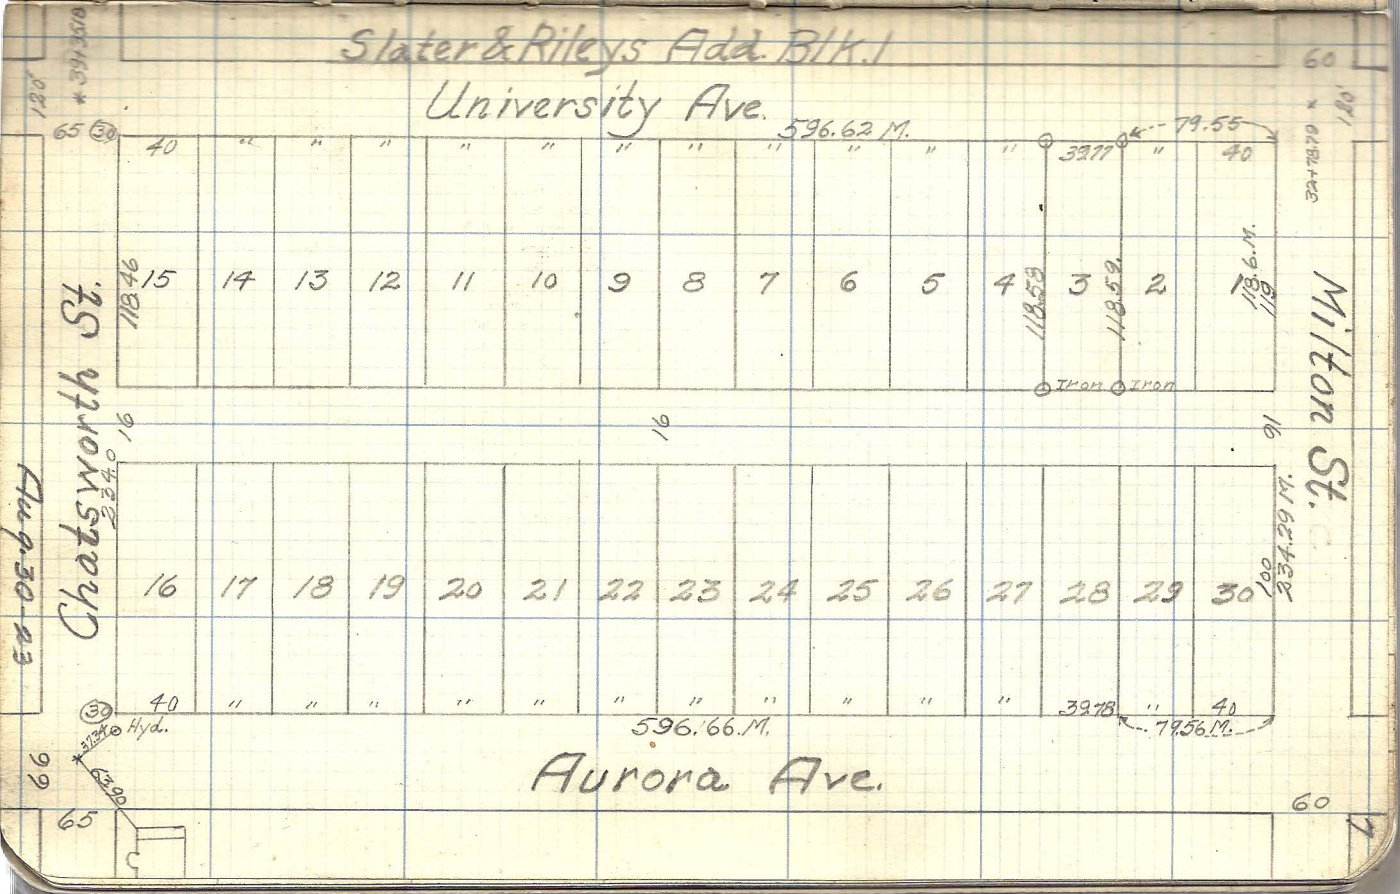
Slater & Rileys Add. Blk. 1
University Ave.
596.62 M.
79.55
3977
40
15
14
13
12
11
10
9
8
7
6
5
4
3
2
1
118.46
118.59
118.6 M.
Iron
Iron
Chatsworth St.
Milton St.
16
16
16
17
18
19
20
21
22
23
24
25
26
27
28
29
30
3978
596.66 M.
79.56 M.
Aurora Ave.
Hyd.
60
65
66
120'